Pack required to be printed in colour

CURO GROUP

Standard House Type Collection

THE AVEBURY

SITE SPECIFIC INFORMATION:

Site Name:	Bath Road, Keynsham P2
Plot No. (AS):	29,37,111
Plot No. (OPP):	1,10,22,48,119,132,206

TYPE SPECIFIC INFORMATION:

Bedrooms:	3B 5P	
Tenure:	Open Market	
Finished Internal Area: *(RICS measured to 1.5m head room to plasterboard finish)*	88.8m²	955.8sq ft
Construction Area:	90.1m²	969.8sq ft

COMPLIANCE INFORMATION:


Building Regulations:	2023
M4(1) / M4(2) / M4(3)	M4(1)
NDSS	No
Other:	N/A

Amended drawings shown in red

DRAWING NO:	DESCRIPTION:	REV:
KEYN/AVE(D)/100	Substructure Layout	C1
KEYN/AVE(D)/200	Ground Floor Plan	C2
KEYN/AVE(D)/201	First Floor Plan	C3
KEYN/AVE(D)/300	Joist Plan	C2
KEYN/AVE(D)/400	Roof Plan	C1
KEYN/AVE(D)/500	Section A-A	C2
KEYN/AVE(D)/501	Section B-B	C1
KEYN/AVE(D)/550	Typical Soldier Course Clipped Eaves Detail	C1
KEYN/AVE(D)/551	Typical Oriel Window Elevations	C1
KEYN/AVE(D)/552	Typical Oriel Window Plan & Roof Plan	C2
KEYN/AVE(D)/553	Typical Oriel Window Section A-A (Timber clad)	C2
KEYN/AVE(D)/554	Typical Oriel Window Section B-B (Timber clad)	C2
KEYN/AVE(D)/600	Front Elevation	C1
KEYN/AVE(D)/601	Side Elevation	C1
KEYN/AVE(D)/602	Rear Elevation	C1
KEYN/AVE(D)/603	Side Elevation	C1
KEYN/AVE(D)/604	Brick Reinforcement Requirements	C1
KEYN/AVE(D)/700	WC Plan and Elevations	C1
KEYN/AVE(D)/701	Bathroom Plan and Elevations	C1
KEYN/AVE(D)/702	En-suite Plan and Elevations	C1
KEYN/AVE(D)/703	Kitchen Plan	C2
KEYN/AVE(D)/800	Schedules, Tables & Legends	C2
KEYN/AVE(D)/900	Ground Floor M&E Plan	C1
KEYN/AVE(D)/901	First Floor M&E Plan	C1
KEYN/AVE(D)/902	Roof M&E Plan	C1
KEYN/AVE(D)/1000	Sales Plans	C1
KEYN/AVE(D)/2000	Designer Risk Assesment	C1

REV:	REVISION DESCRIPTION:	DATE:
-	First Issue - Superstructure Tender	07.02.25
C1	Construction Issue	03.03.26
C2	Standard detail changed to not include radon barrier. Oven note added as per client comments. Internal door setting out dimensions added. W2, W10 lintel and D5 reviewed and amended.	16.04.26
C3	Oriel roof updated to single ply membrane.	11.05.26
C4	Roof Steel replaced with Girder Truss	26.05.26

NOTE: *This drawing is the copyright of Curo Group, All rights reserved. DO NOT scale from this drawing. This drawing is only to be used on the site for which specified

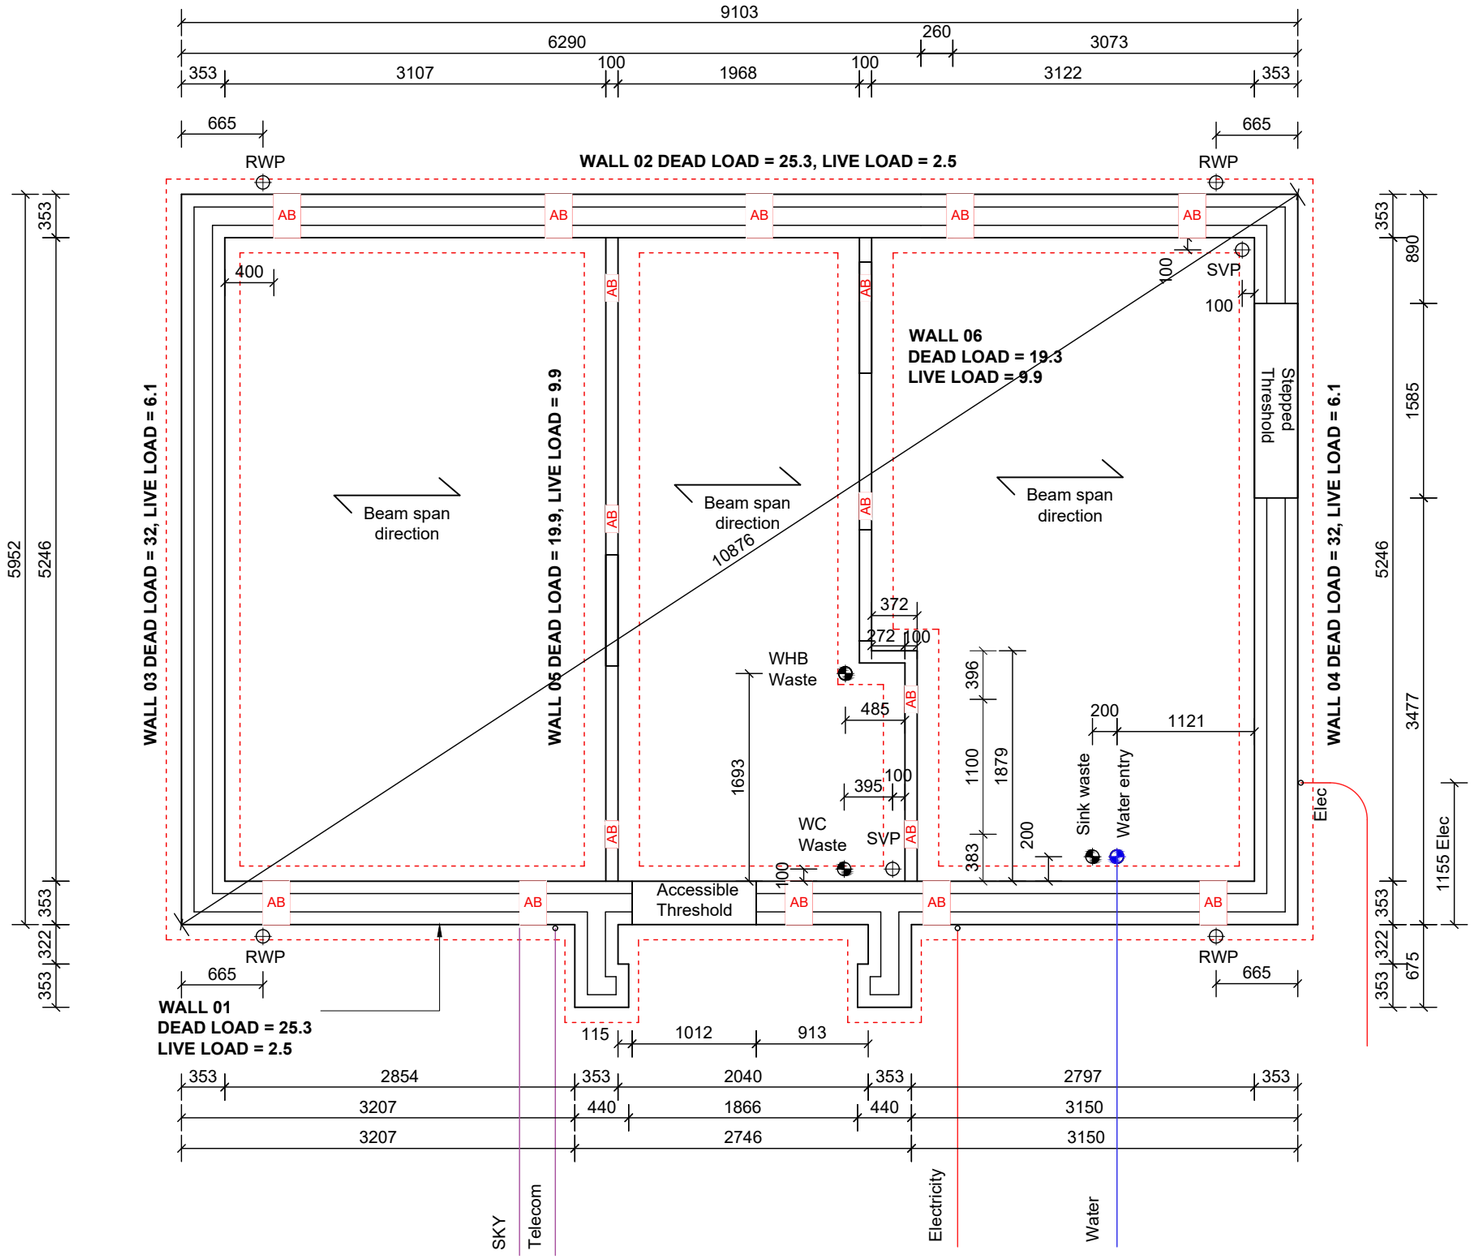

Air Brick Notes

AB

Indicates location of air bricks in strict accordance with NHBC Chapters 5.2.10 & Technical guidance 6.1.

To be minimum 75mm above external ground level in accordance with NHBC Technical guidance 6.1.

Location of air bricks calculated in accordance with NHBC 5.2.10 ventilation. Either 1500mm2 per metre run of external wall or 500mm2 per m2 of floor area whichever gives the greater opening area.

Ventilators should be spaced at no more than 2m centres and within 450mm of the end of any wall.

Amount of ventilators calculated using Rytons Periscope underfloor ventilator with Multifix air bricks as below.

Free area total	Total run of external walls (added together)	Min. Amount of vents Required	Free area total
44mm2	30m	6	45,000mm2

Tenure: Open Market

AS
Plots 29, 37, 111

OPP
Plots 1, 10, 22, 48, 119, 132, 206

Notes

Foundations are indicative only. Please refer to site specific Structural Engineers design for individual proposals.

Refer to design drawings for details of beam & block floor configuration.

Site specific drainage design must be undertaken to suit existing services arrangement.

Rev.	Description.	Date.	Initial.
C1	Construction Issue	04.03.26	NW
-	Superstructure Tender Issue	07.02.25	NS

CONSTRUCTION

CURO GROUP

Standard House Type Collection

PROJECT
Bath Road, Keynsham P2

HOUSE TYPE
AVEBURY

DRAWING TITLE
FOUNDATION LAYOUT

-


SCALE	DATE	AUTHOR	CHK'D
1:50 @A3	Nov 24	NS	AK

DRAWING NO.
KEYN/AVE(D)/100

REV
C1

NOTE: *This drawing is the copyright of Curo Group, All rights reserved. DO NOT scale from this drawing. This drawing is only to be used on the site for which specified

FOR EXTERNAL OPENINGS & INTERNAL DOORS SCHEDULES REFER TO DRAWING 800

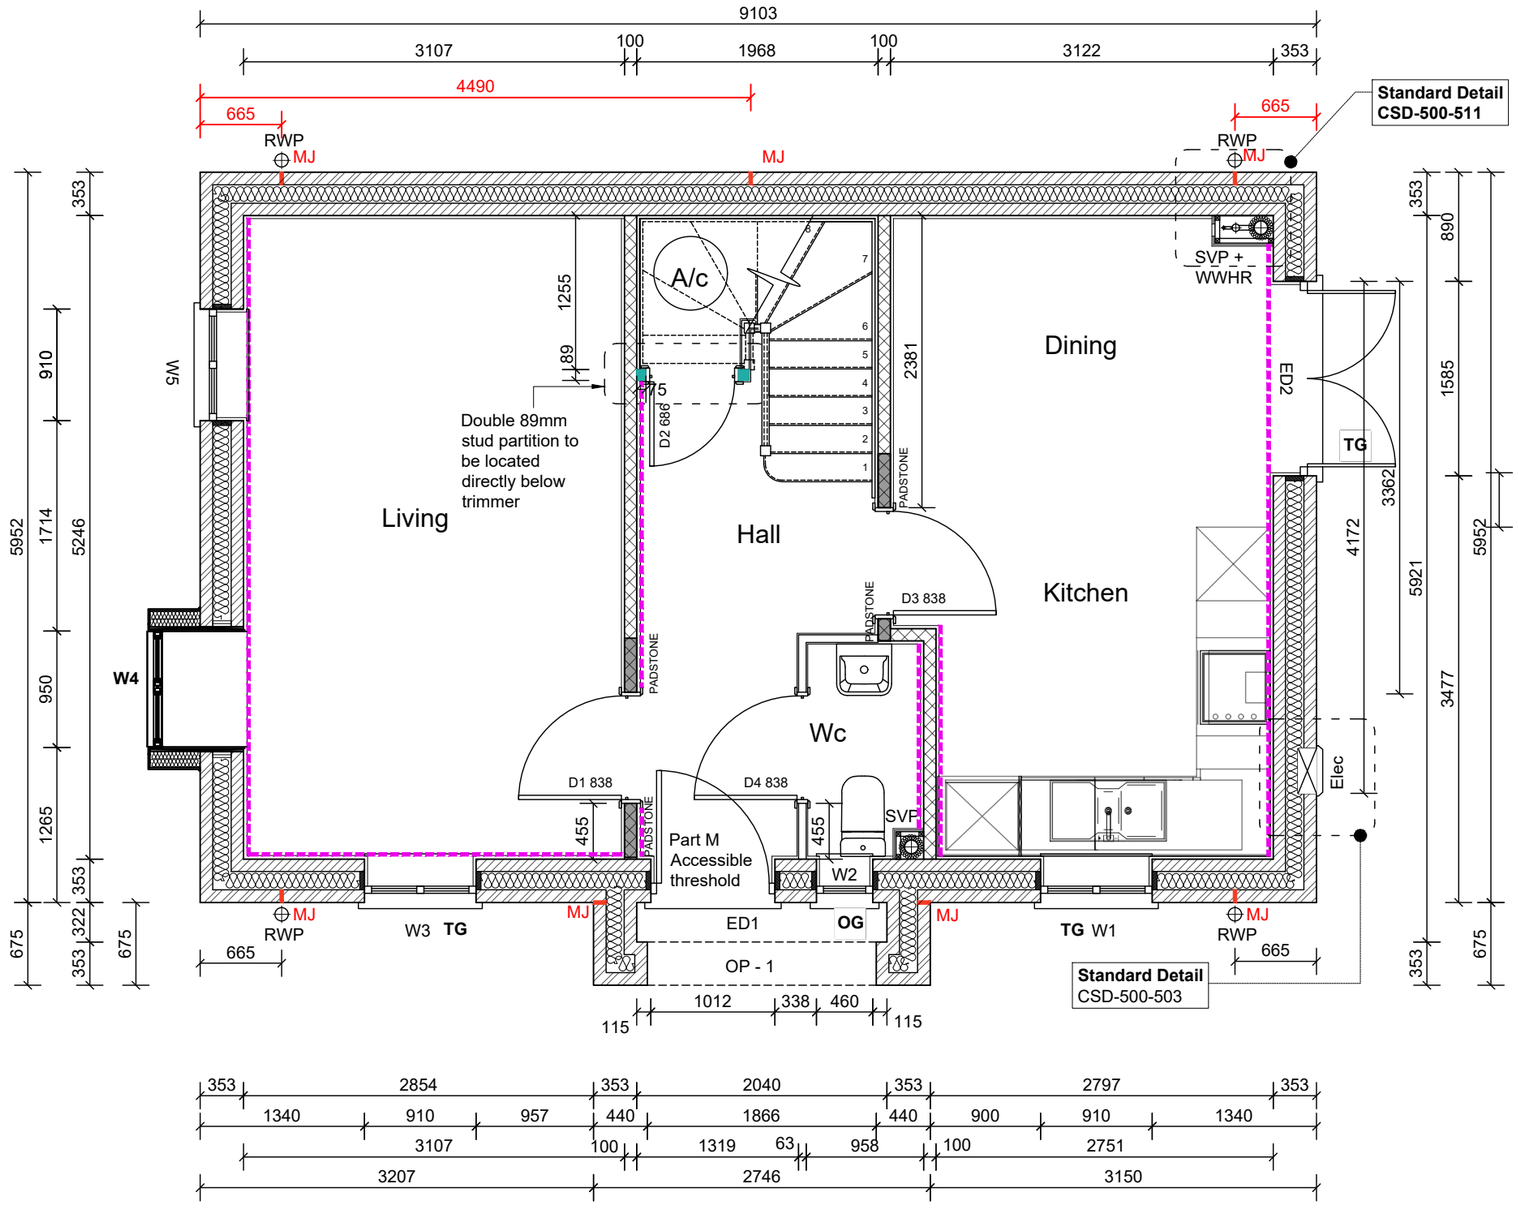

Wall Legend (150mm Cavity)

Standard External Insulated Cavity Wall
103mm facing concrete brick outer leaf
150mm Blown Springvale Platinum Bead insulation
100mm aerated blockwork 7.3N/mm2, M4 mortar
12.5mm plasterboard on dabs with taped joints

Loadbearing Block Wall
100mm medium density blockwork
12.5mm plasterboard on dabs with taped joints

Where indicated plasterboard dabs to be 20mm to allow for pipework to radiators

Non Loadbearing Stud Partition
12.5mm Gypsum Wallboard
63 x 38mm timber studs & noggins
12.5mm Gypsum Wallboard

Stud Partition With Acoustic Insulation
12.5mm Gypsum Wallboard
63 x 38mm timber studs with 65mm thick Isover APR acoustic insulation packed between
12.5mm Gypsum Wallboard

BATHROOMS, EN-SUITES & CLOAKS SUBSTITUTE WALLBOARD WITH 12.5mm GYPROC MOISTURE RESISTANT BOARD

This drawing should be read in conjuction with Prostructure's designs and specifications for the padstones and lintels.

Tenure: Open Market

AS
Plots 29, 37, 111

OPP
Plots 1, 10, 22, 48, 119, 132, 206

Key

TG	Toughened glazing
OG	Obscure glazing
EG	Escape window with guarding
FR	Fixed shut fire rated glazing

Rev.	Description.	Date.	Initial.
C2	Internal Door setting out dimensions added. DIM to W4 amended.	17.04.26	NW
C1	Construction Issue	04.03.26	NW
-	Superstructure Tender Issue	07.02.25	NS

CONSTRUCTION

CURO GROUP

Standard House Type Collection

PROJECT
Bath Road, Keynsham P2

HOUSE TYPE
AVEBURY (Detached)

DRAWING TITLE
GROUND FLOOR PLAN
-


SCALE	DATE	AUTHOR	CHK'D
1:50 @A3	Feb 24	LB	AF

DRAWING NO.
KEYN/AVE(D)/200

REV
C2

NOTE: *This drawing is the copyright of Curo Group, All rights reserved. DO NOT scale from this drawing. This drawing is only to be used on the site for which specified

FOR EXTERNAL OPENINGS & INTERNAL DOORS SCHEDULES REFER TO DRAWING 800

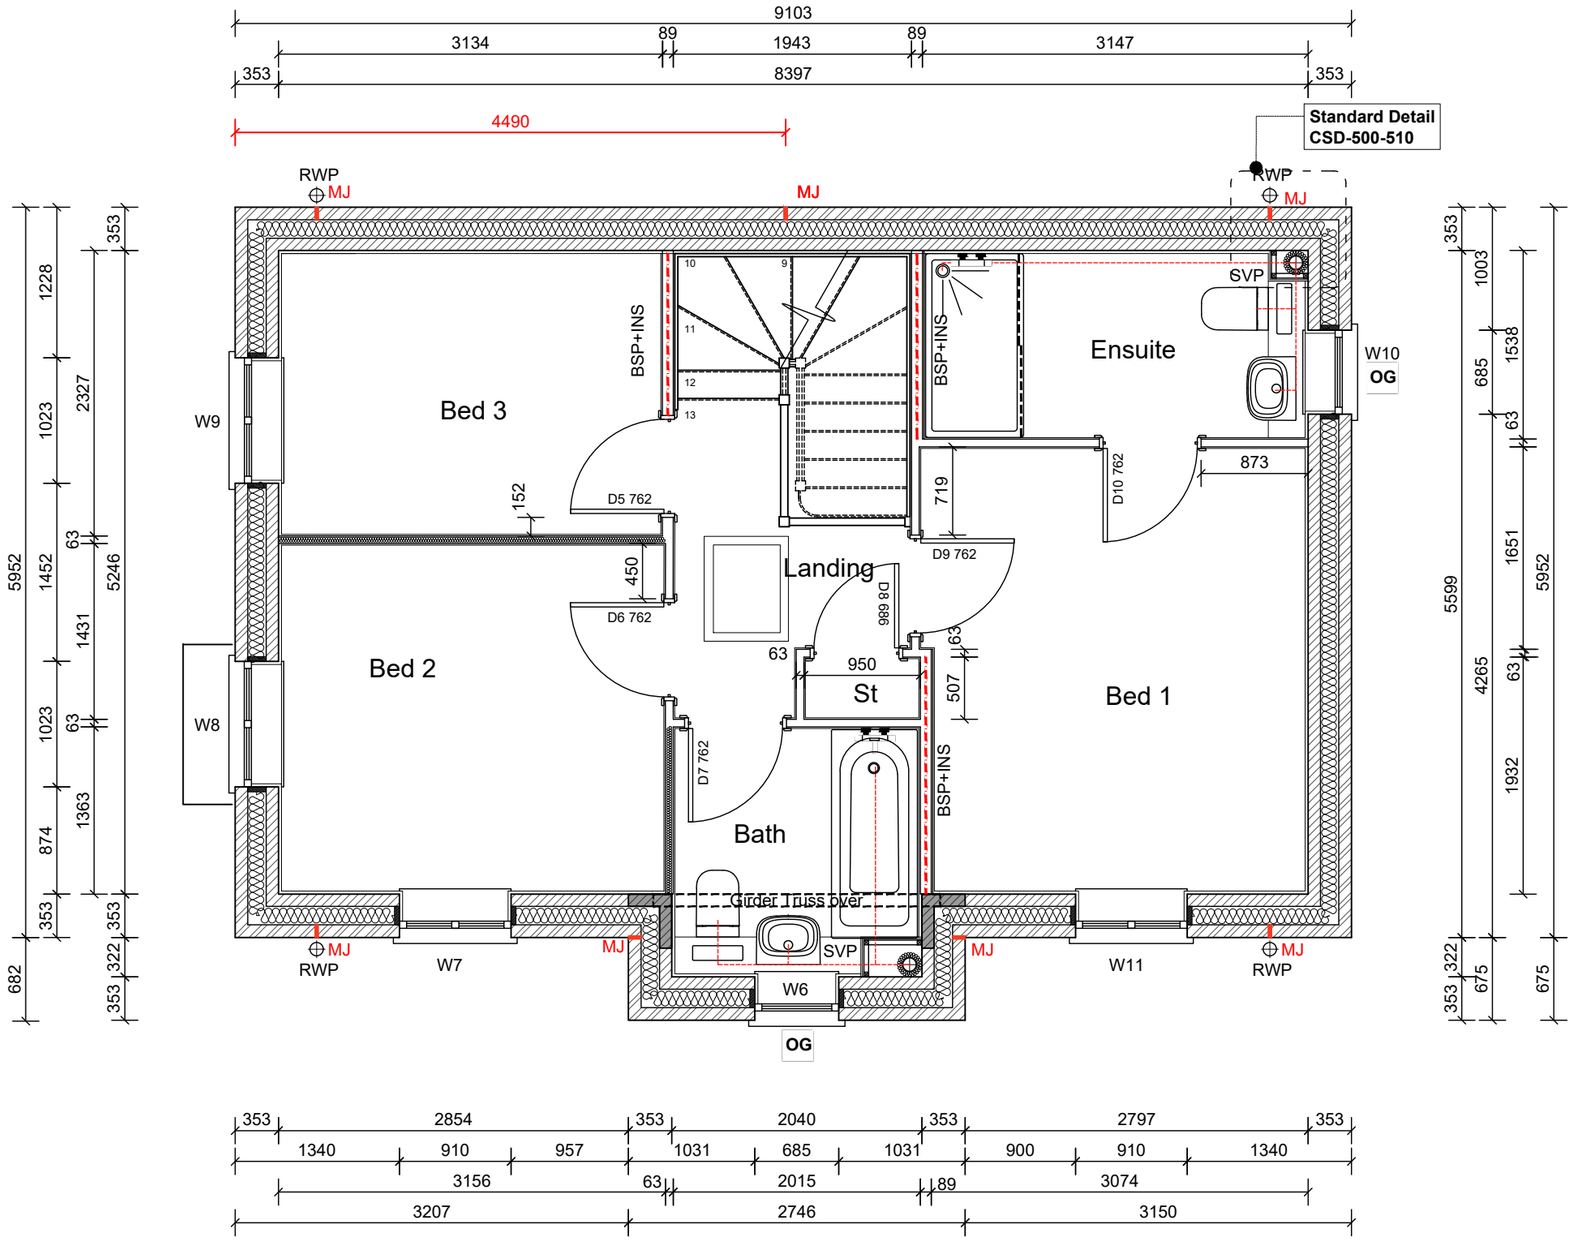

Wall Legend (150mm Cavity)

Standard External Insulated Cavity Wall
103mm facing concrete brick outer leaf
150mm Unilin CT/PIR insulation, 5mm Low-E Cavity
100mm aerated blockwork 3.6N/mm2
12.5mm plasterboard on dabs with taped joints

Non Loadbearing Stud Partition
12.5mm Gypsum Wallboard
63 x 38mm timber studs & noggins
Where indicated with Batten Hatch to be Acoustic Partition Packed with 65mm thick Isover APR acoustic insulation
12.5mm Gypsum Wallboard

SDW
SDW+INS

Structural Stud Diaphragm Wall
12.5mm Gypsum Wallboard
12.5mm OSB Sheathing to one side
47 x 75mm timber studs at 600 ctrs
Where indicated with INS to be Acoustic Partition
Packed with 65mm thick Isover APR acoustic insulation
12.5mm Gypsum Wallboard

BSP
BSP+INS

Buttress Stud Partition
12.5mm Gypsum Wallboard
9mm Plywood OSB (external)
38 x 89mm dp (min) C16 timber studs at 400cts
Where indicated with INS to be Acoustic Partition
Packed with 65mm thick Isover APR acoustic insulation
12.5mm Gypsum Wallboard
refer to Structural Engineers design for fixings

BATHROOMS, EN-SUITES & CLOAKS SUBSTITUTE WALLBOARD WITH 12.5mm GYPROC MOISTURE RESISTANT BOARD

This drawing should be read in conjuction with Prostructure's designs and specifications for the padstones and lintels.

Tenure: Open Market

AS
Plots 29, 37, 111

OPP
Plots 1, 10, 22, 48, 119, 132, 206

Key

TG	Toughened glazing
OG	Obscure glazing
EG	Escape window with guarding
FR	Fixed shut fire rated glazing

Rev.	Description.	Date.	Initial.
C3	Steel Beam replaced with Girder Truss	26.05.26	AK
C2	Internal Door setting out dimensions added	17.04.26	NW
C1	Construction Issue	04.03.26	NW
-	Superstructure Tender Issue	07.02.25	NS

CONSTRUCTION

CURO GROUP

Standard House Type Collection

PROJECT
Bath Road, Keynsham P2

HOUSE TYPE
AVEBURY (Detached)


DRAWING TITLE
FIRST FLOOR PLAN
-

SCALE	DATE	AUTHOR	CHK'D
1:50 @A3	Feb 24	LB	AF

DRAWING NO.
KEYN/AVE(D)/201

REV
C3

NOTE: *This drawing is the copyright of Curo Group, All rights reserved. DO NOT scale from this drawing. This drawing is only to be used on the site for which specified

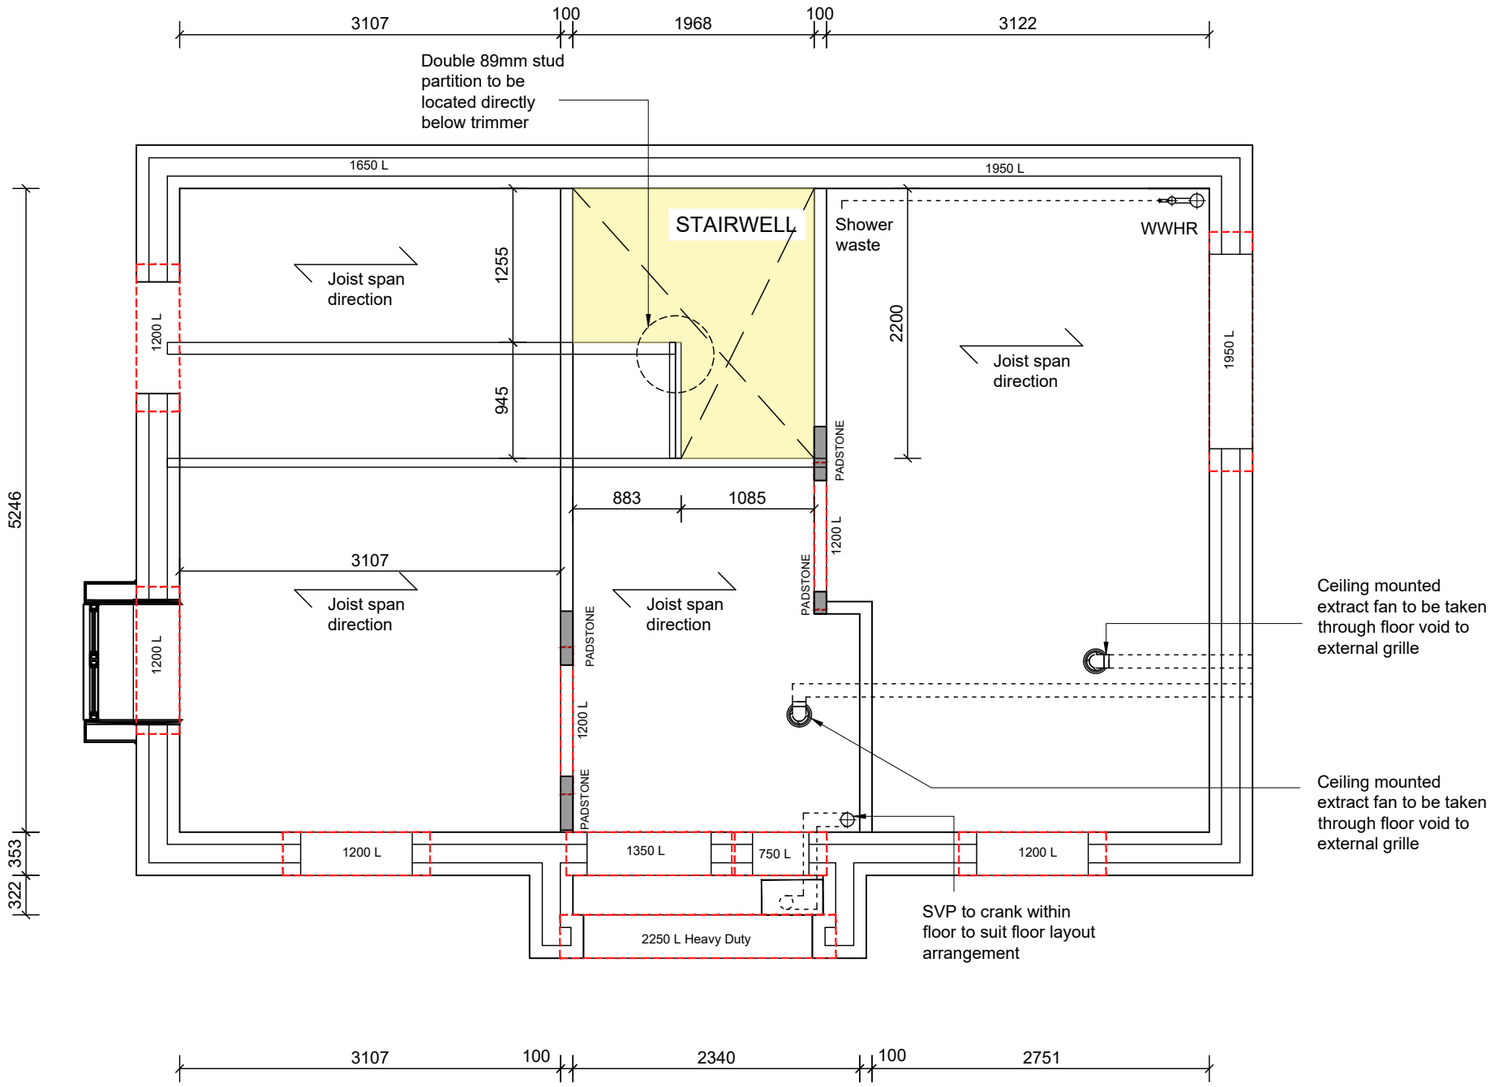

Notes

Layout shown is indicative only. Please refer to specialist fabricators drawings for full design & details.

Design to be compliant with BS 5268 Part 2 joist centres nominally 600mm - fabricators drawing to provide all setting out.

Joist depths to be 253mm maximum.

Joists to be built into external & party walls with propreitary joists seals or suitably sealed with sealant.

Floor construction to achieve min 40dB and 30 minutes fire resistance to all floors. 22mm thick particle board flooring providing a min mass 15kg/m2. 15mm thick plasterboard finish providing a mass 9.8 kg/m2. 6mm plywood underlayment required to bathroom & en-suite floors to receive tiling.

30 x 5mm section galvanised M.S lateral restraint straps at max 2000mm ctrs. To be fixed across first 3 joists in accordance with manufacturers design & locations

Tenure: Open Market

AS
Plots 29, 37, 111

OPP
Plots 1, 10, 22, 48, 119, 132, 206

Rev.	Description.	Date.	Initial.
C1	Construction Issue	04.03.26	NW
-	Superstructure Tender Issue	07.02.25	NS

CONSTRUCTION

CURO GROUP

Standard House Type Collection

PROJECT
Bath Road, Keynsham P2

HOUSE TYPE
AVEBURY (Detached)


DRAWING TITLE
JOIST PLAN
-

SCALE	DATE	AUTHOR	CHK'D
1:50 @A3	Feb 24	LB	AF

DRAWING NO.
KEYN/AVE(D)/300

REV
C1

NOTE: *This drawing is the copyright of Curo Group, All rights reserved. DO NOT scale from this drawing. This drawing is only to be used on the site for which specified

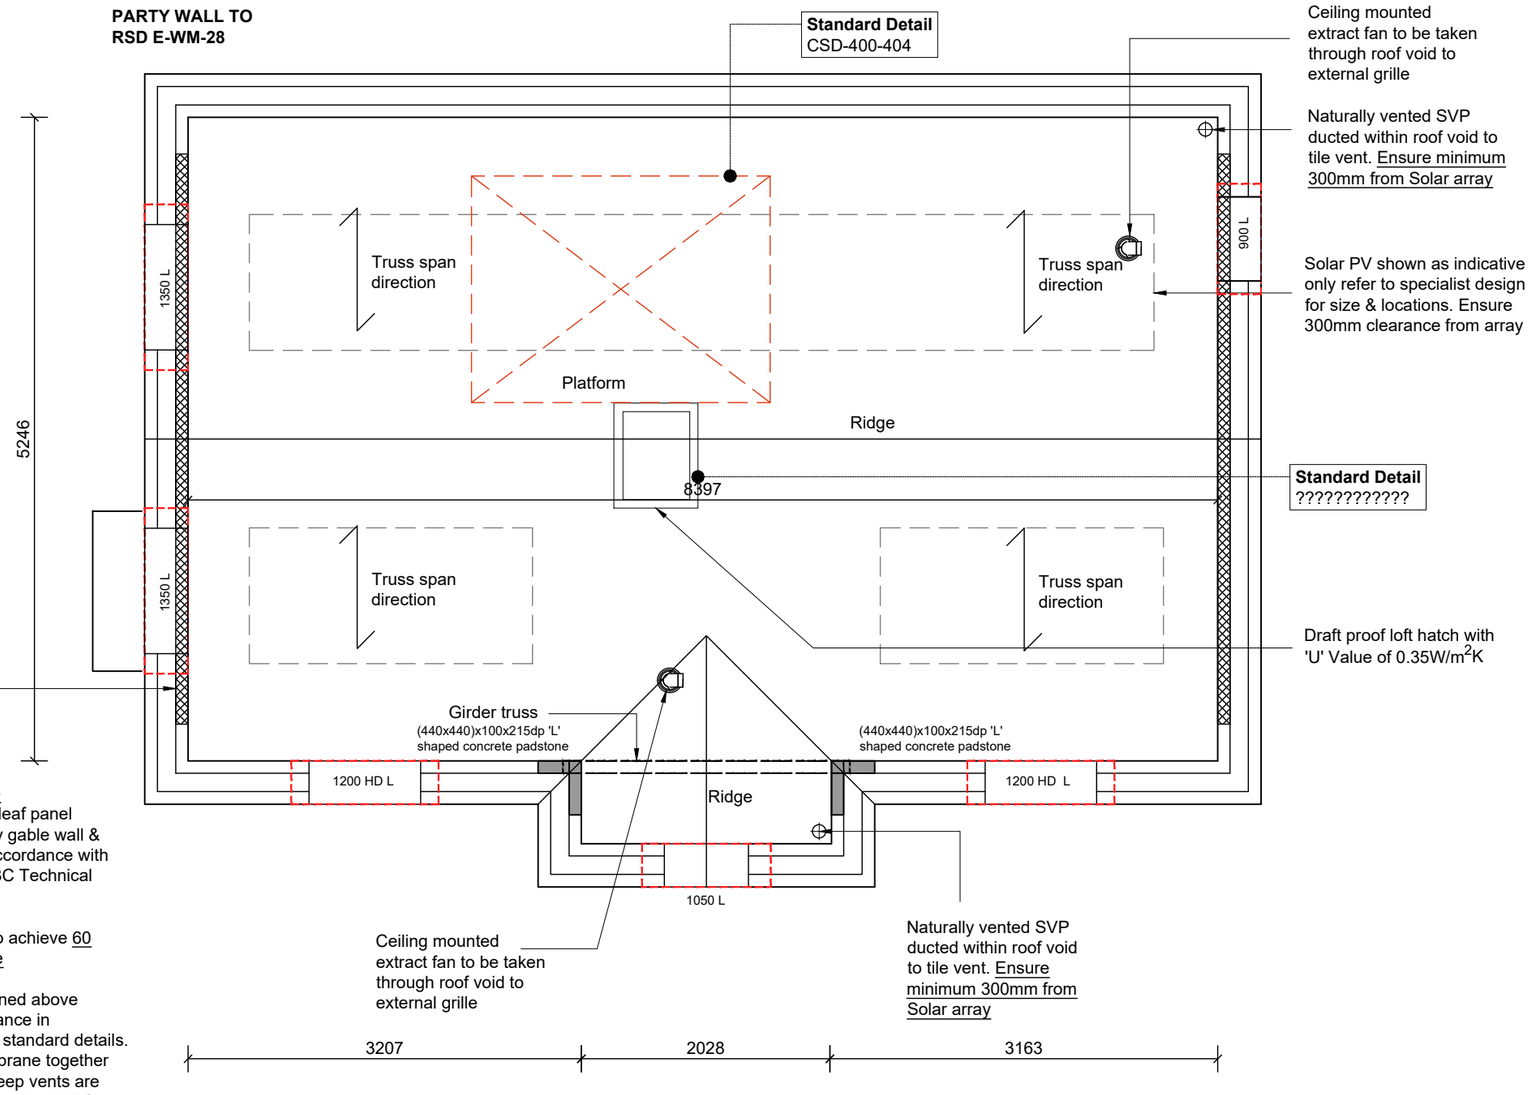

Gable Spandrel Note
Spandrel to be single leaf panel supported on masonry gable wall & constructed in strict accordance with standard detail & NHBC Technical Guidance 7.2/25.

Spandrel to be lined to achieve 60 minutes fire resistance

Spandrel to be positioned above wallplate with the distance in accordance with Curo standard details. Ensure breather membrane together with cavity tray and weep vents are installed in accordance with NHBC Technical Guidance 7.2/25.

Notes

Roof truss layout designed and installed in strict accordance with approved manufacturers instructions and details

30 x 5mm Galvanised M.S. straps to secure roof at each gable at ceiling & rafter level across min 3 trusses at max 2000mm centres in accordance with manufacturers design & locations

Solar PV notes:

- Refer to Eco2solar or similar approved drawings for accurate location and plotting of PV panels. Locations shown on this drawing are indicative only
- Ensure any tile vents are either ducted to external wall or tile vents which are located minimum 300mm away from Solar array
- Install 1200mm x 2000mm working platform to allow safe access & egress for the Electrician & maintenance
- Install 2 vertical timber upright posts approx 600mm apart. Fire retardant board to fixed to uprights. Inverter to be fitted to fire board
- Site electrical contractor to install a continuous 6mm twin & earth from the consumer via a (local) loop & then to the loft space

For detailed guidance refer to Eco2solar or similar approved site guide document

Tenure: Open Market

AS
Plots 29, 37, 111

OPP
Plots 1, 10, 22, 48, 119, 132, 206

Rev.	Description.	Date.	Initial.
C2	Steel Beam replaced with Girder Truss	26.05.26	AK
C1	Construction Issue	04.03.26	NW
-	Superstructure Tender Issue	07.02.25	NS

CONSTRUCTION

CURO GROUP

Standard House Type Collection

PROJECT
Bath Road, Keynsham P2

HOUSE TYPE
AVEBURY (Detached)

DRAWING TITLE
ROOF PLAN


-

SCALE	DATE	AUTHOR	CHK'D
1:50 @A3	Feb 24	LB	AF

DRAWING NO.
KEYN/AVE(D)/400

REV
C2

NOTE: *This drawing is the copyright of Curo Group, All rights reserved. DO NOT scale from this drawing. This drawing is only to be used on the site for which specified

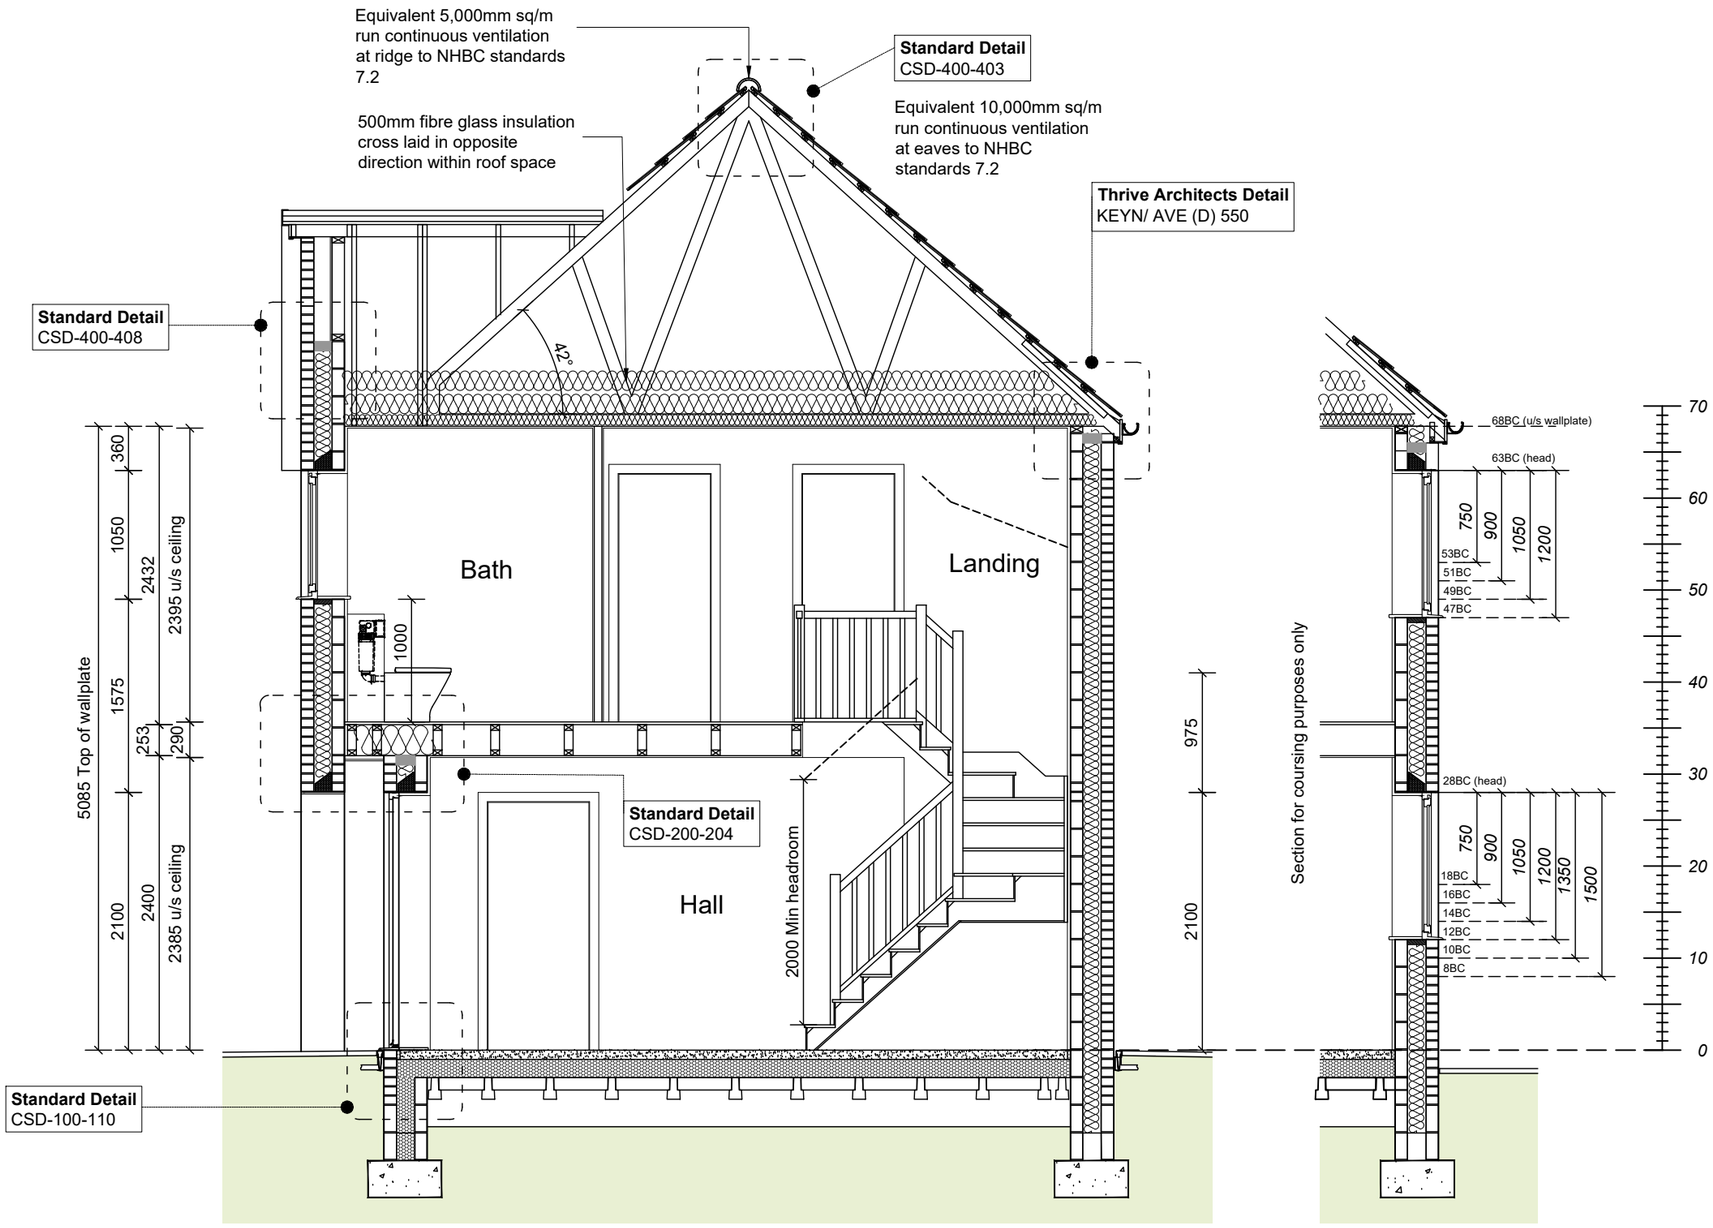

Foundations are shown indicatively & subject to confirmation by Structural Engineer

Tenure: Open Market

AS
Plots 29, 37, 111

OPP
Plots 1, 10, 22, 48, 119, 132, 206

Rev.	Description.	Date.	Initial.
C2	Standard detail changed to not include radon barrier.	16.04.26	NW
C1	Construction Issue	04.03.26	NW
-	Superstructure Tender Issue	07.02.25	NS

CONSTRUCTION

CURO GROUP

Standard House Type Collection

PROJECT
Bath Road, Keynsham P2

HOUSE TYPE
AVEBURY (Detached)

DRAWING TITLE
SECTION A-A

-

SCALE	DATE	AUTHOR	CHK'D
1:50 @A3	Feb 24	LB	AF

DRAWING NO.
KEYN/AVE(D)/500


REV
C2

NOTE: *This drawing is the copyright of Curo Group, All rights reserved. DO NOT scale from this drawing. This drawing is only to be used on the site for which specified

Gable Spandrel Note
Spandrel to be single leaf panel supported on masonry gable wall & constructed in strict accordance with standard detail & NHBC Technical Guidance 7.2/25.
Spandrel to be lined to achieve 60 minutes fire resistance

Equivalent 5,000mm sq/m run continuous ventilation at ridge to NHBC standards 7.2

500mm fibre glass insulation cross laid in opposite direction within roof space

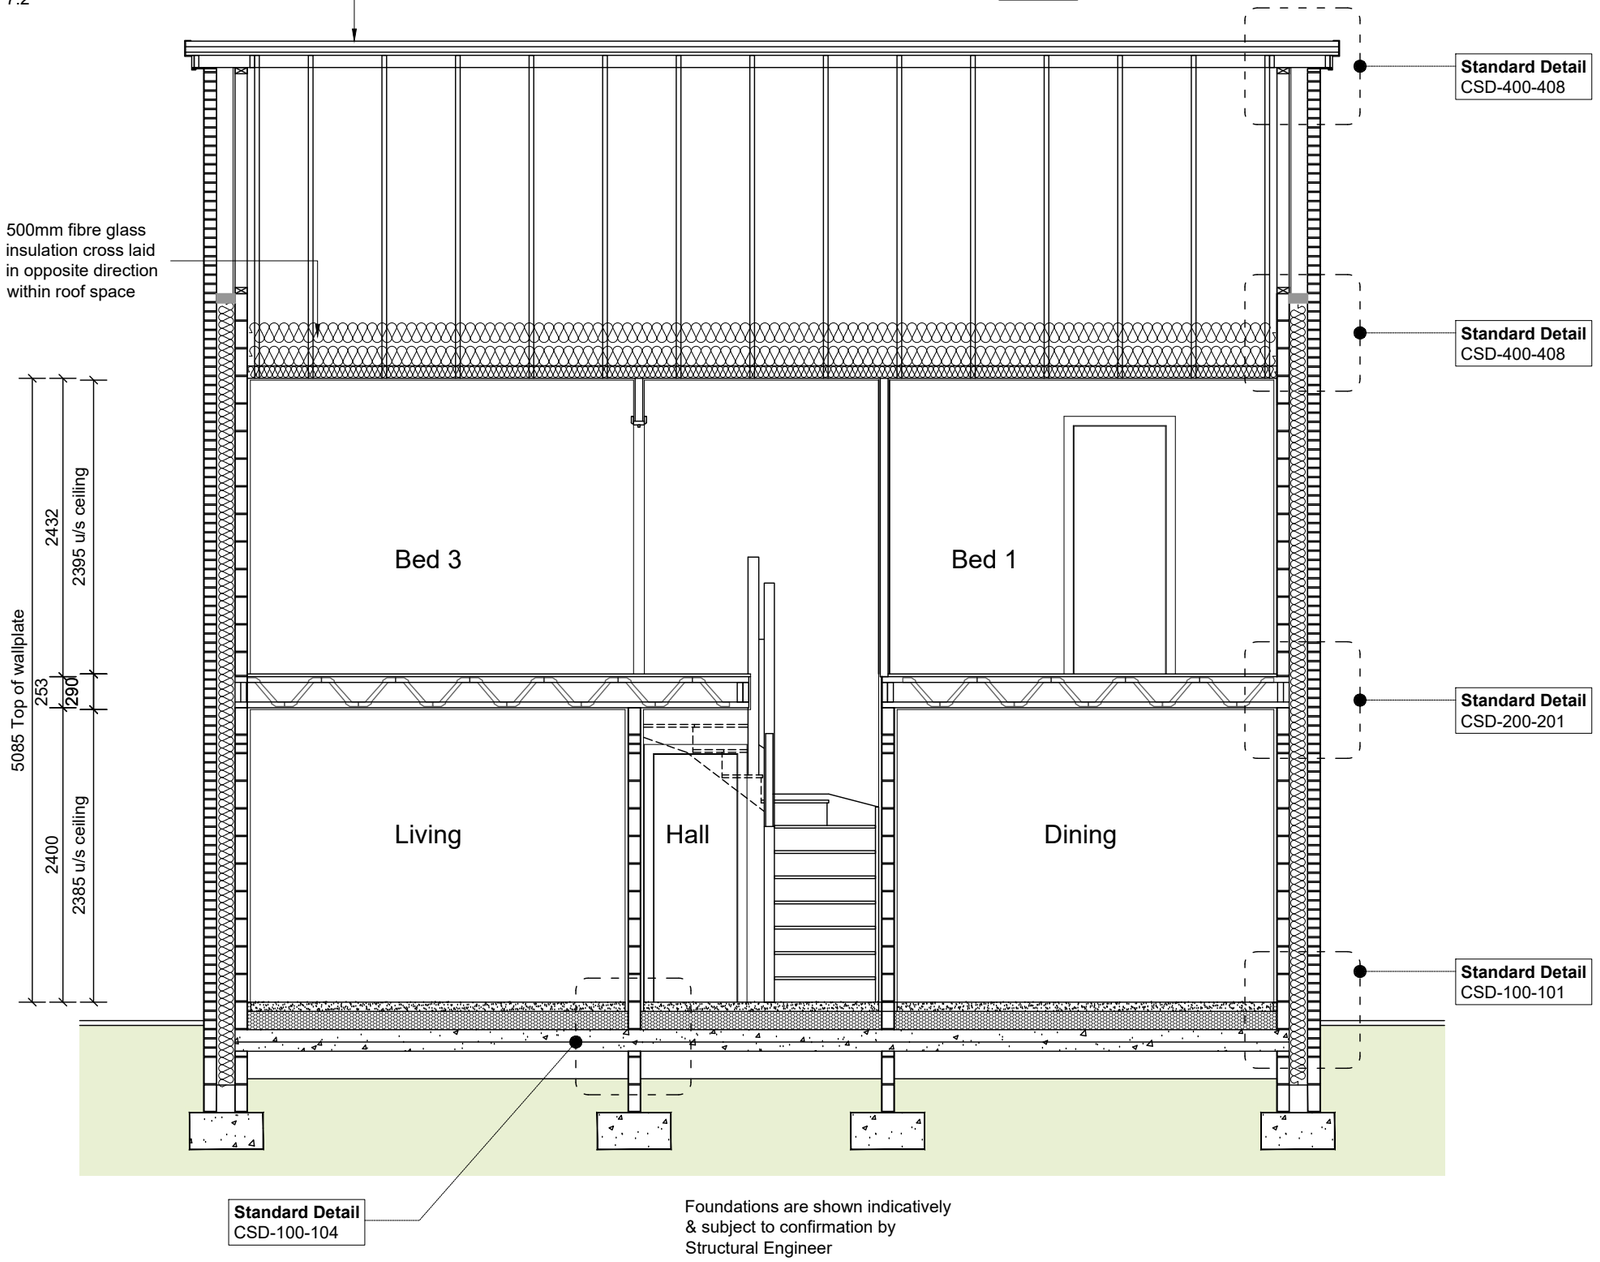

Foundations are shown indicatively & subject to confirmation by Structural Engineer

Tenure: Open Market

AS
Plots 29, 37, 111

OPP
Plots 1, 10, 22, 48, 119, 132, 206

Rev.	Description.	Date.	Initial.
C1	Construction Issue	04.03.26	NW
-	Superstructure Tender Issue	07.02.25	NS

CONSTRUCTION

CURO GROUP

Standard House Type Collection

PROJECT
Bath Road, Keynsham P2

HOUSE TYPE
AVEBURY (Detached)

DRAWING TITLE
SECTION B-B


-

SCALE	DATE	AUTHOR	CHK'D
1:50 @A3	Feb 24	LB	AF

DRAWING NO.
KEYN/AVE(D)/501

REV
C1

NOTE: *This drawing is the copyright of Curo Group, All rights reserved. DO NOT scale from this drawing. This drawing is only to be used on the site for which specified

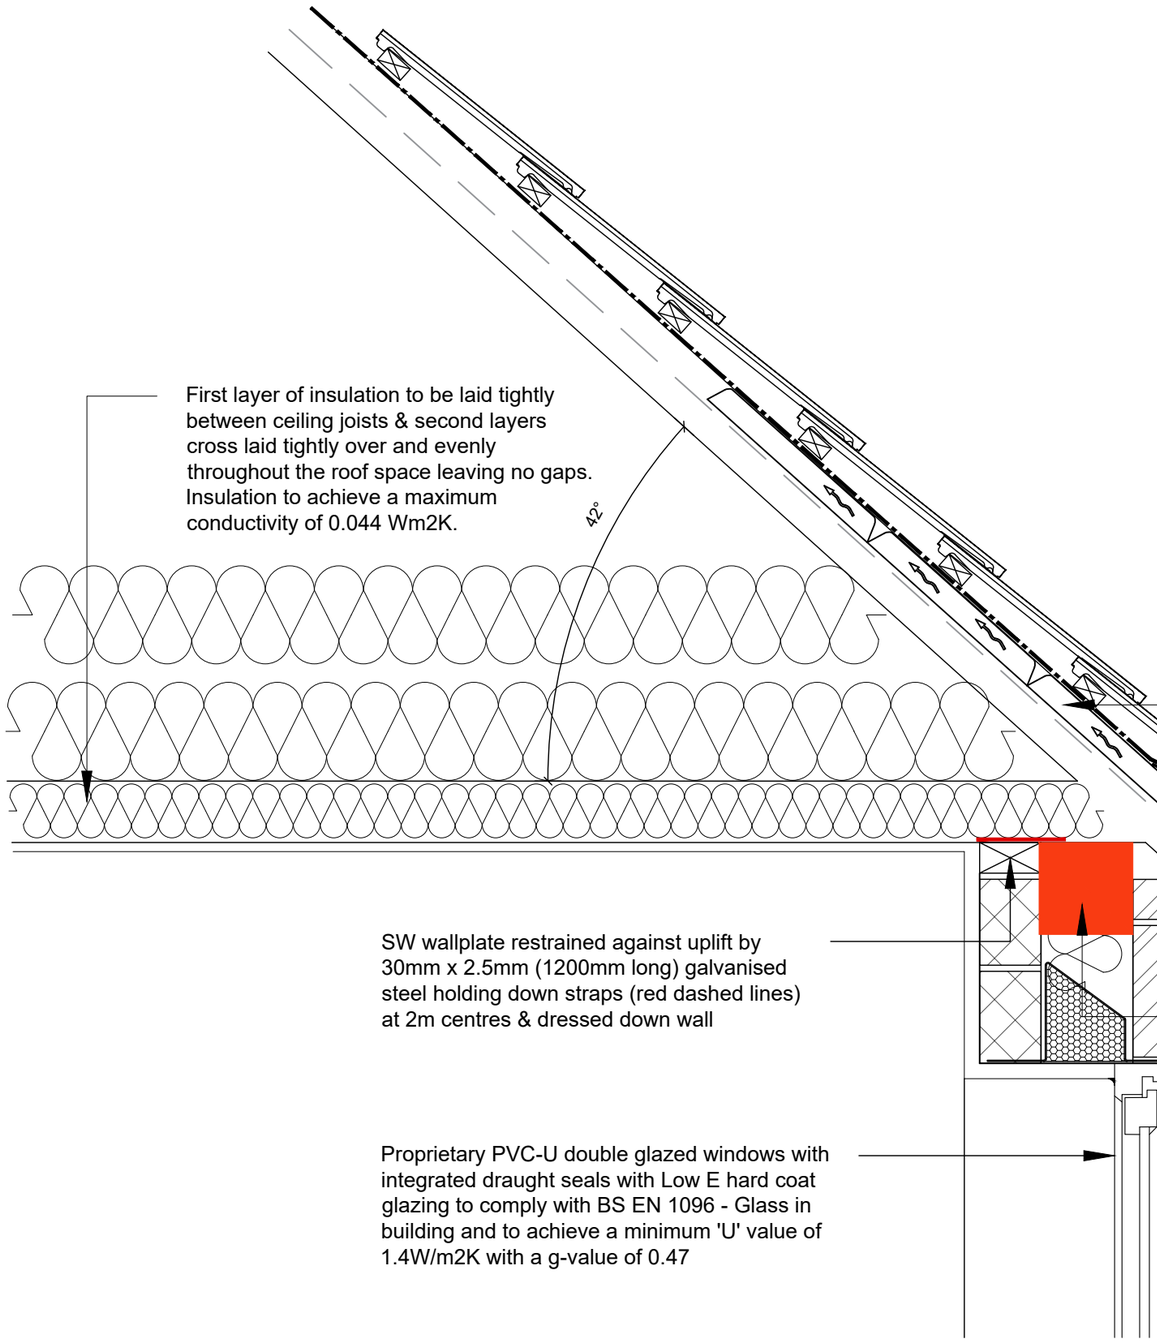

First layer of insulation to be laid tightly between ceiling joists & second layers cross laid tightly over and evenly throughout the roof space leaving no gaps. Insulation to achieve a maximum conductivity of 0.044 Wm2K.

SW wallplate restrained against uplift by 30mm x 2.5mm (1200mm long) galvanised steel holding down straps (red dashed lines) at 2m centres & dressed down wall

Proprietary PVC-U double glazed windows with integrated draught seals with Low E hard coat glazing to comply with BS EN 1096 - Glass in building and to achieve a minimum 'U' value of 1.4W/m2K with a g-value of 0.47

Cold Roof Ventilation note:
10,1000mm2/m ventilation provided at eaves with additional 5,000mm2/m at ridge. Suitable for LR or HR roof underlay in accordance with NHBC 7.2.15

Marley universal rafter roll or equivalent to maintain min. 50mm clear ventilation pathway between insulation and roof membrane

Eurocell or similar approved fascia with fascia vent, to give equivalent of 10mm continuous vent

Soldier brick course over window head

ARC or Mayplas MP552 horizontal masonry cavity stop sock providing minimum 30 minutes fire resistance. Minimum compression of 15mm required. Maximum conductivity 0.037 Wm2K

Rev.	Description.	Date.	Initial.
C1	Construction Issue	04.03.26	NW

CONSTRUCTION

CURO GROUP

Standard House Type Collection

PROJECT
Bath Road, Keynsham P2

HOUSE TYPE
AVEBURY (Detached)


DRAWING TITLE
TYPICAL SOLDIER COURSE CLIPPED EAVES DETAIL


SCALE	DATE	AUTHOR	CHK'D
1:10 @A3	Feb 24	CB	AK

DRAWING NO.
KEYN/AVE(D)/550

REV
C1

NOTE: *This drawing is the copyright of Curo Group, All rights reserved. DO NOT scale from this drawing. This drawing is only to be used on the site for which specified

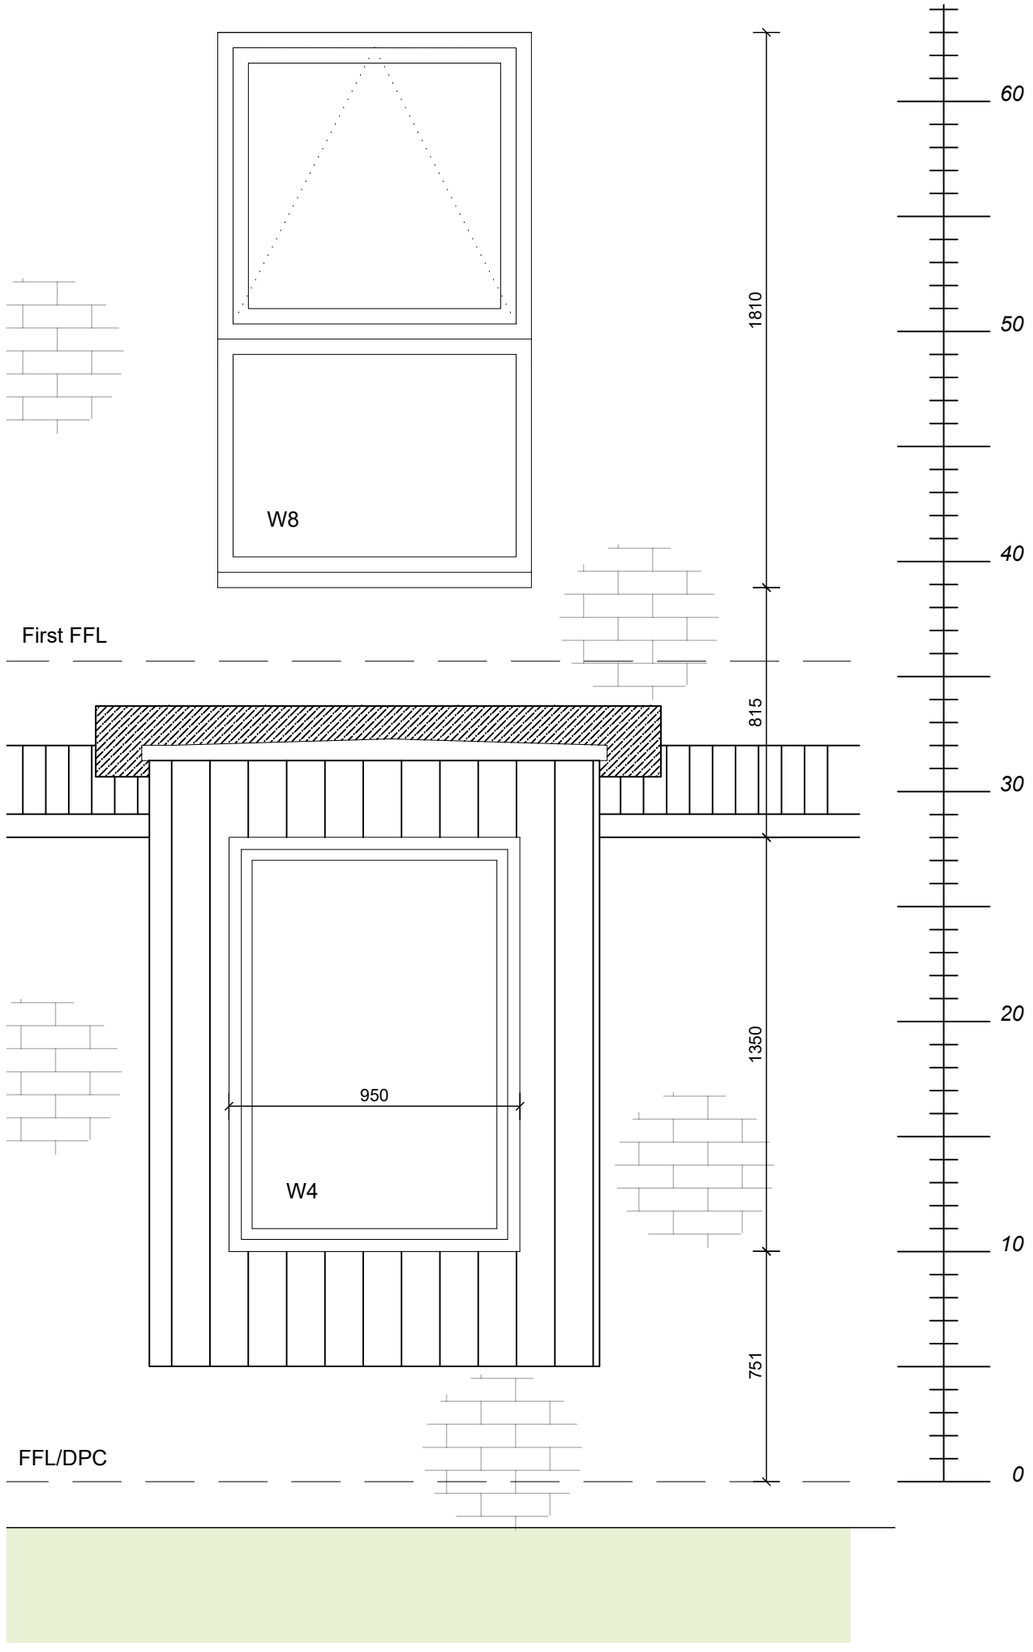

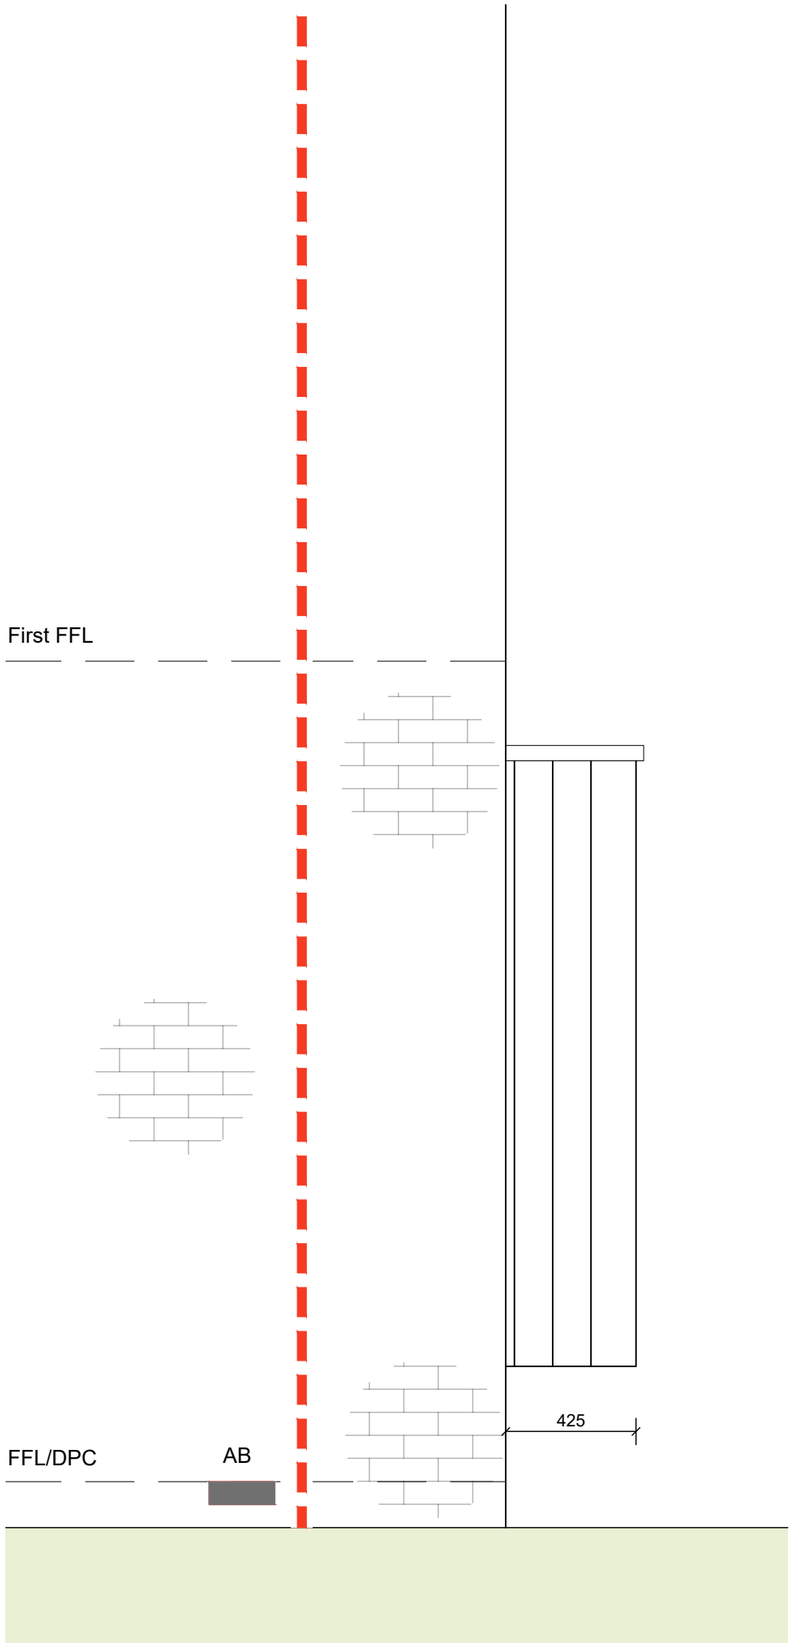

Rev.	Description.	Date.	Initial.
C1	Construction Issue	04.03.26	NW

CONSTRUCTION

CURO GROUP

Standard House Type Collection

PROJECT
Bath Road, Keynsham P2

HOUSE TYPE
AVEBURY (Detached)


DRAWING TITLE
TYPICAL ORIEL WINDOW ELEVATIONS (TIMBER CLAD)

SCALE	DATE	AUTHOR	CHK'D
1:20 @A3	Feb 24	CB	AK


DRAWING NO.
KEYN/AVE(D)/551

REV
C1

NOTE: *This drawing is the copyright of Curo Group, All rights reserved. DO NOT scale from this drawing. This drawing is only to be used on the site for which specified

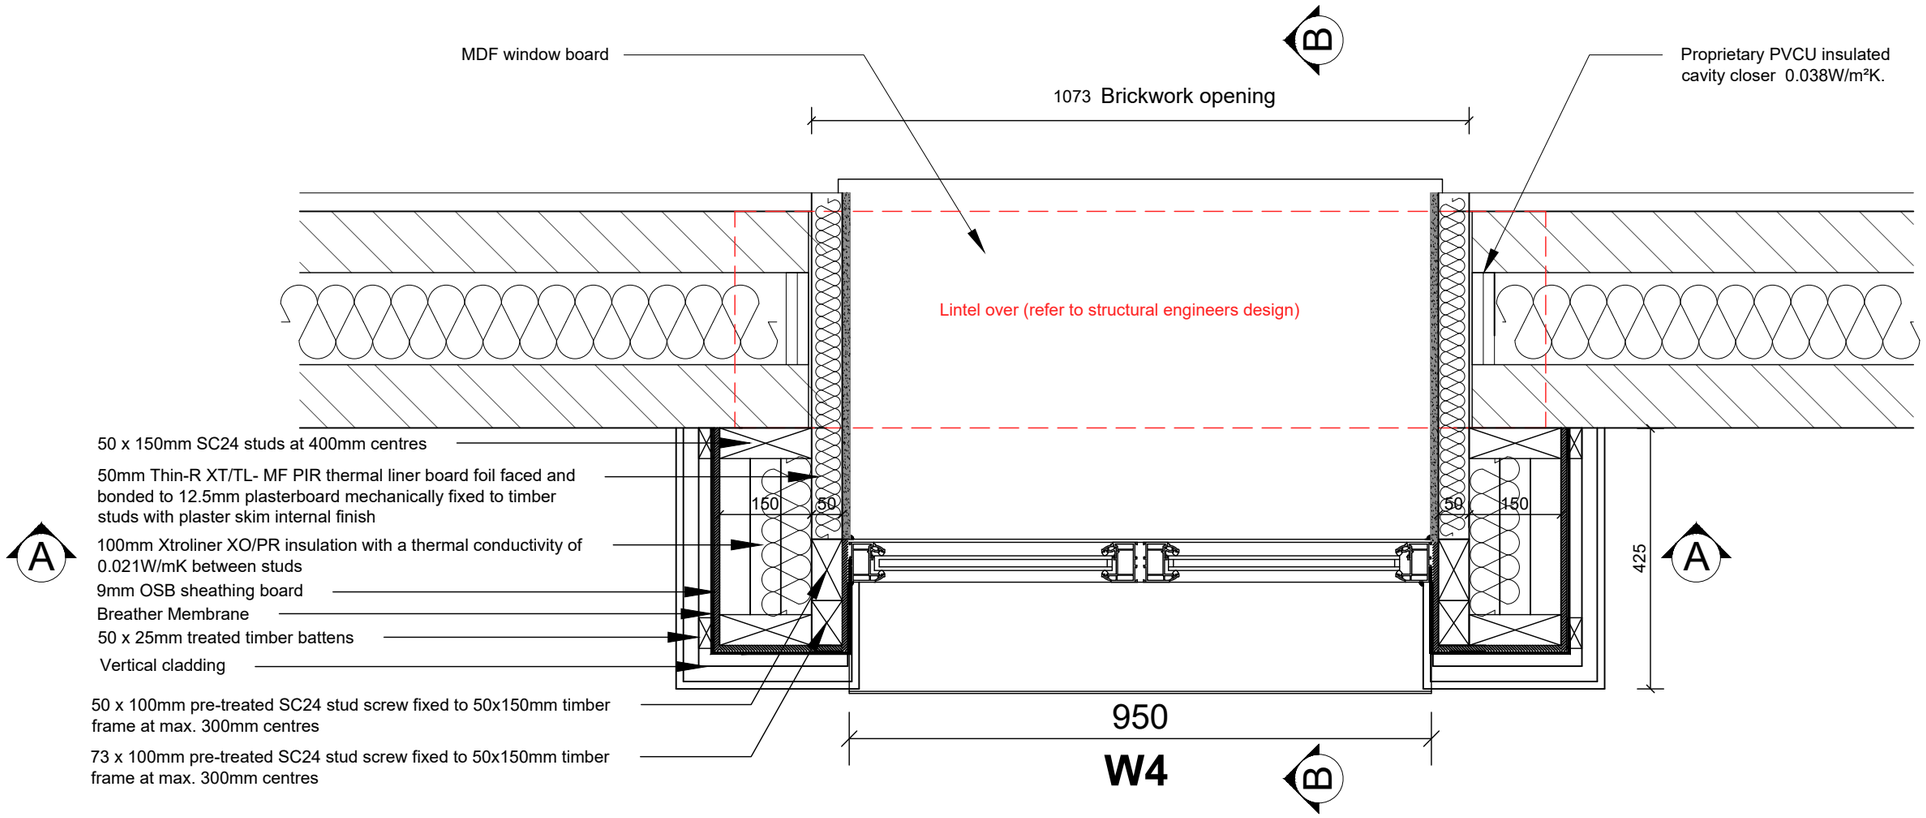

Typical Oriel Window Plan (Timber Clad)1:10

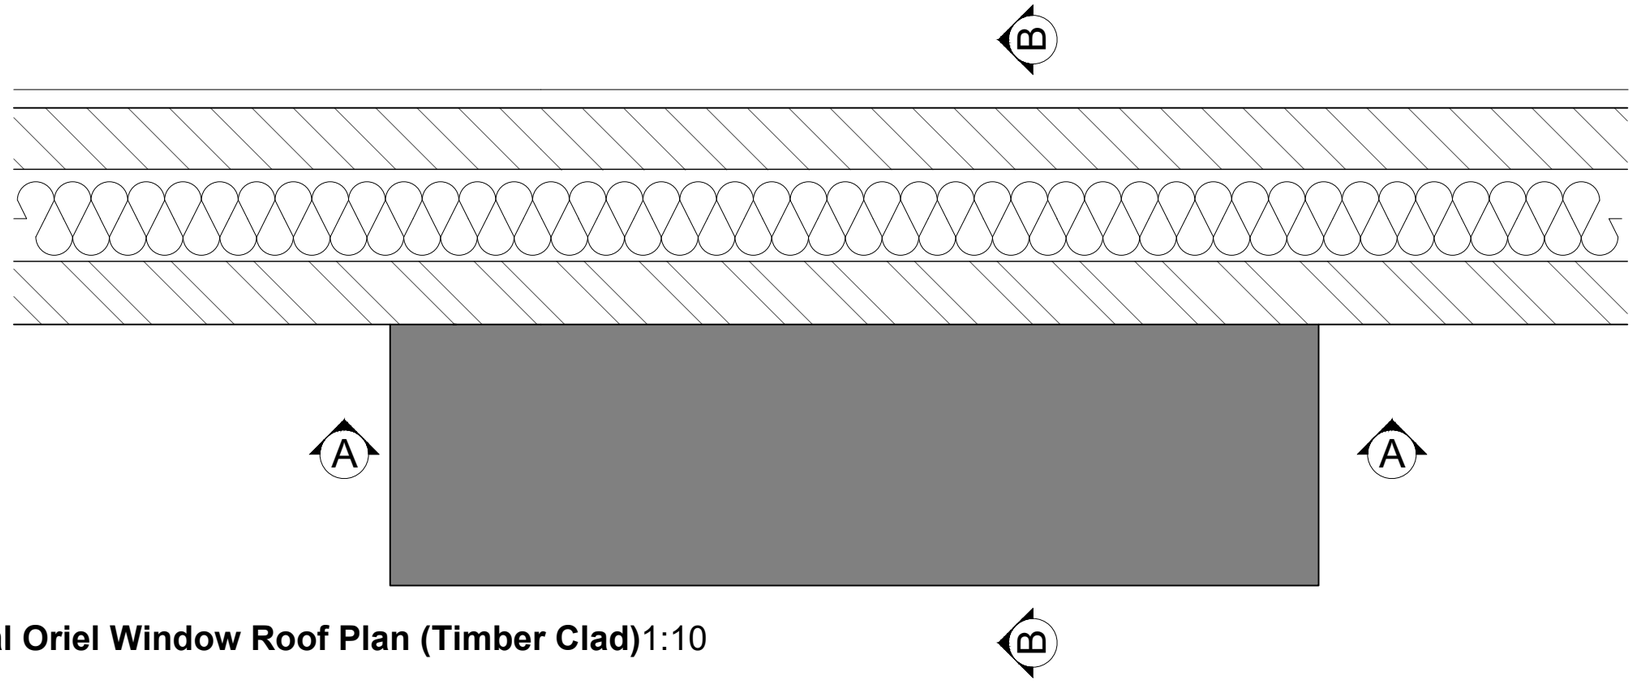

Typical Oriel Window Roof Plan (Timber Clad)1:10

Rev.	Description.	Date.	Initial.
C2	Oriel roof updated to single ply membrane.	11.05.26	AK
C1	Construction Issue	04.03.26	NW

CONSTRUCTION

CURO GROUP

Standard House Type Collection

PROJECT
Bath Road, Keynsham P2

HOUSE TYPE
AVEBURY (Detached)


DRAWING TITLE
TYPICAL ORIEL WINDOW
PLAN & ROOF PLAN

SCALE	DATE	AUTHOR	CHK'D
1:10 @A3	Feb 24	CB	AK

DRAWING NO.
KEYN/AVE(D)/552

REV
C2

NOTE: *This drawing is the copyright of Curo Group, All rights reserved. DO NOT scale from this drawing. This drawing is only to be used on the site for which specified

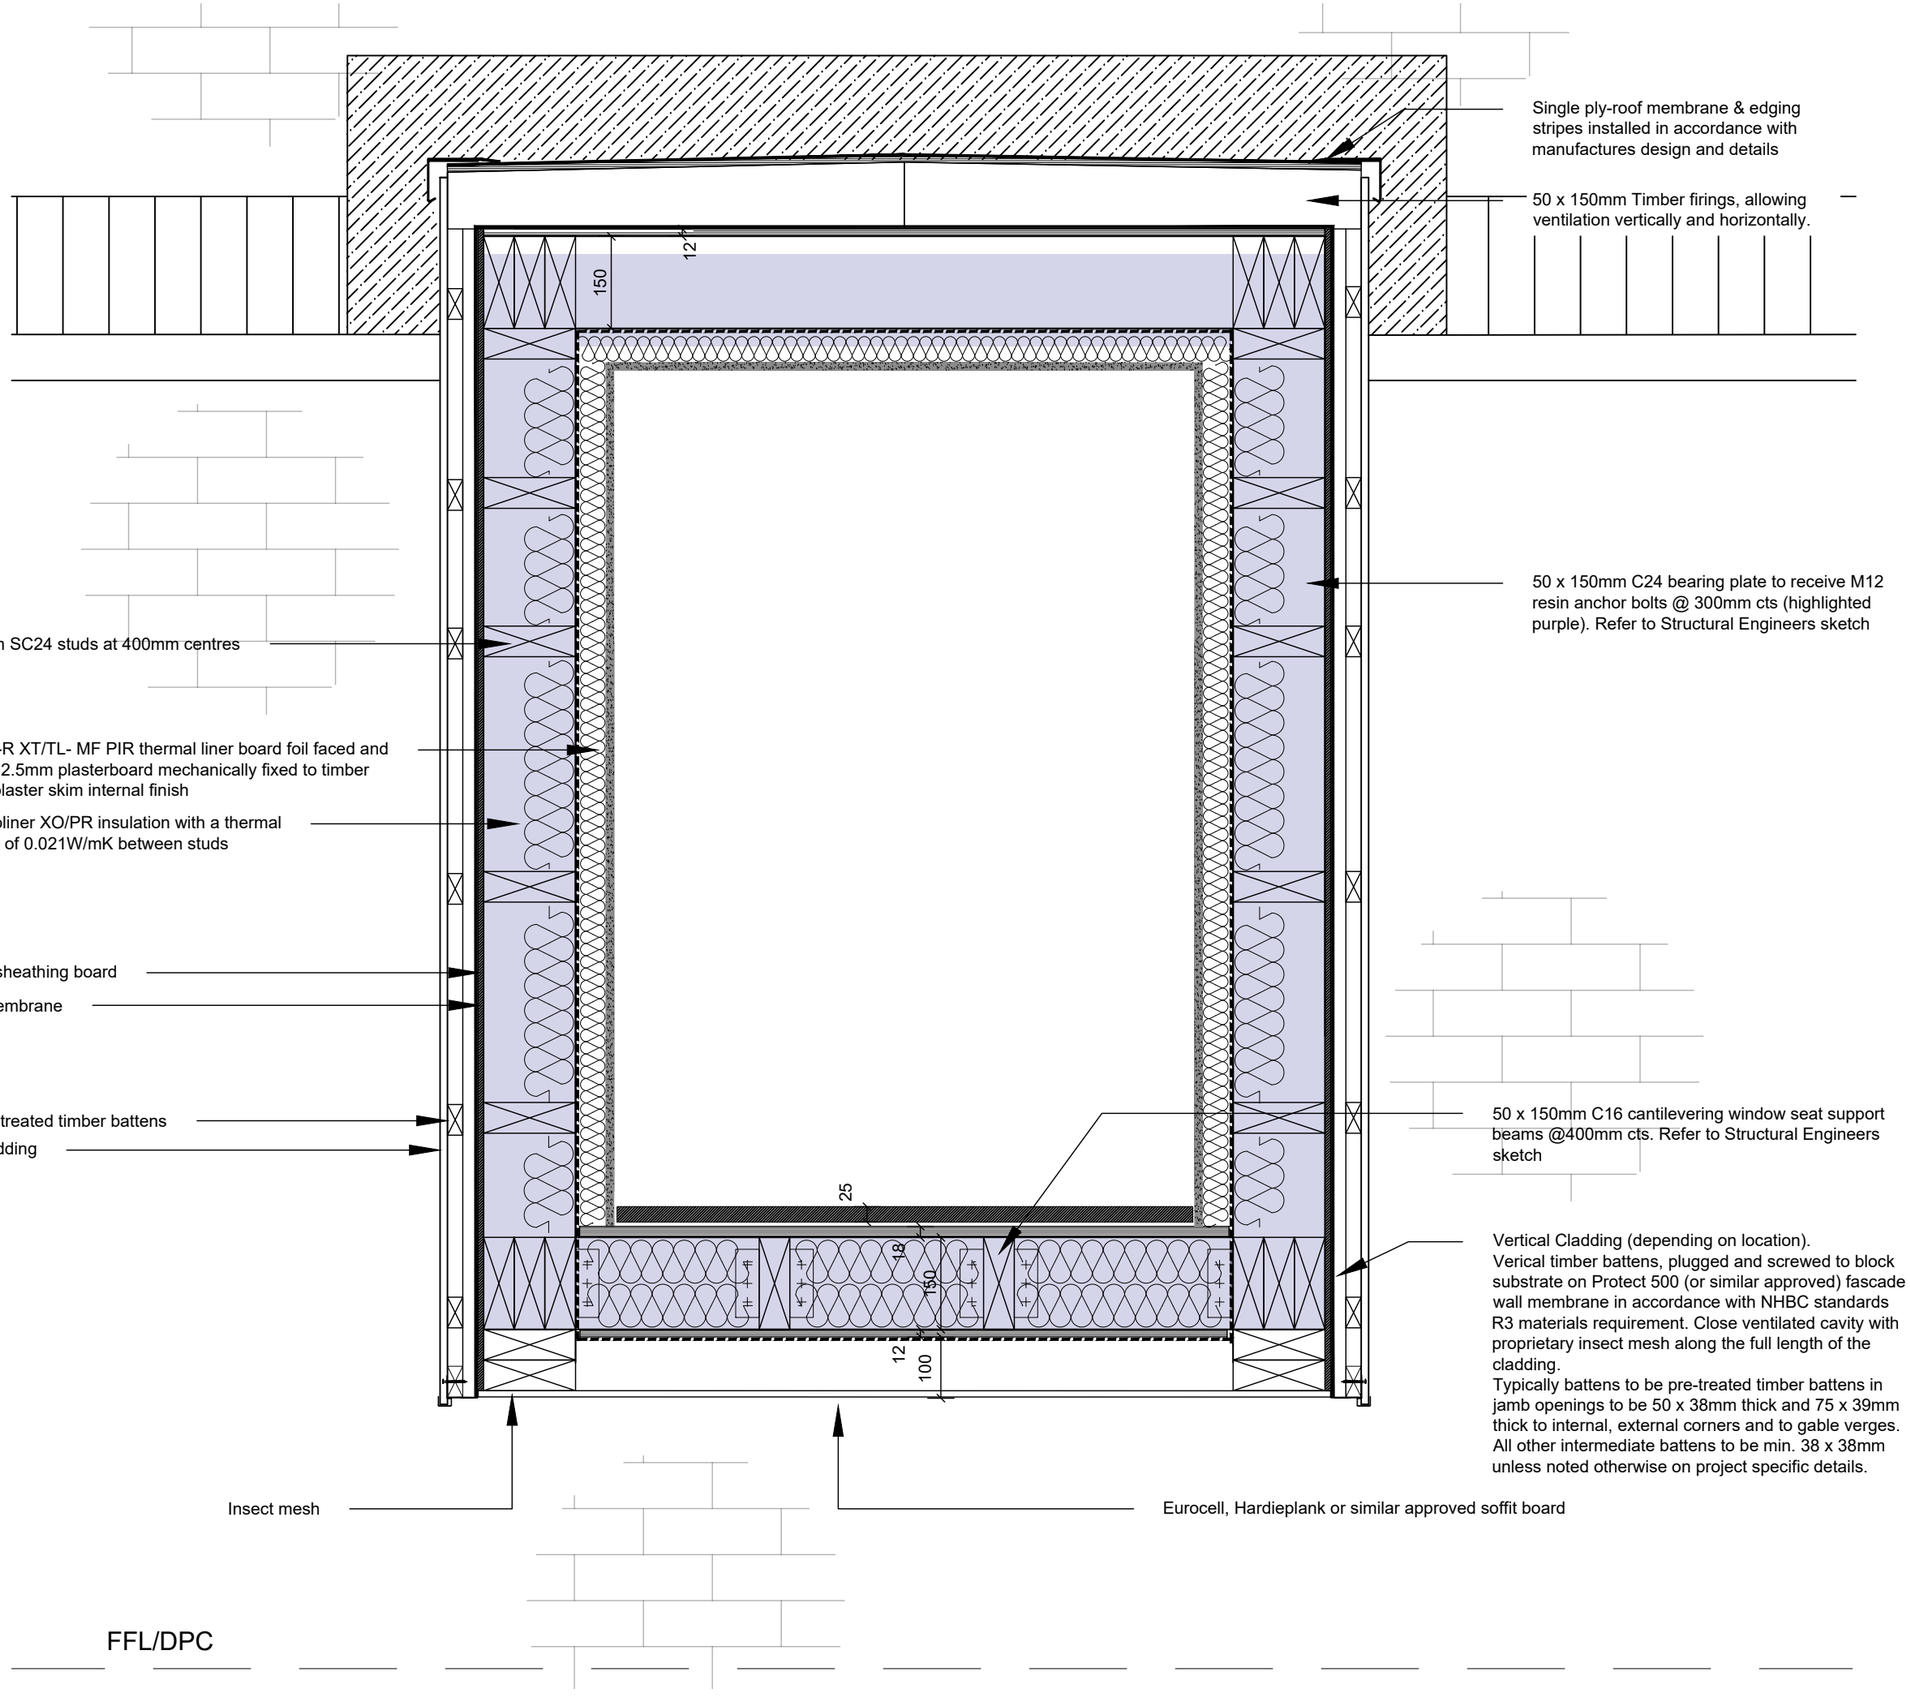

Rev.	Description.	Date.	Initial.
C2	Oriel roof updated to single ply membrane.	11.05.26	AK
C1	Construction Issue	04.03.26	NW

CONSTRUCTION

CURO GROUP

Standard House Type Collection

PROJECT
Bath Road, Keynsham P2

HOUSE TYPE
AVEBURY (Detached)


DRAWING TITLE
TYPICAL ORIEL WINDOW
SECTION A-A (TIMBER CLAD)

SCALE	DATE	AUTHOR	CHK'D
1:10 @A3	Feb 24	CB	AK

DRAWING NO.
KEYN/AVE(D)/553

REV
C2

NOTE: *This drawing is the copyright of Curo Group, All rights reserved. DO NOT scale from this drawing. This drawing is only to be used on the site for which specified

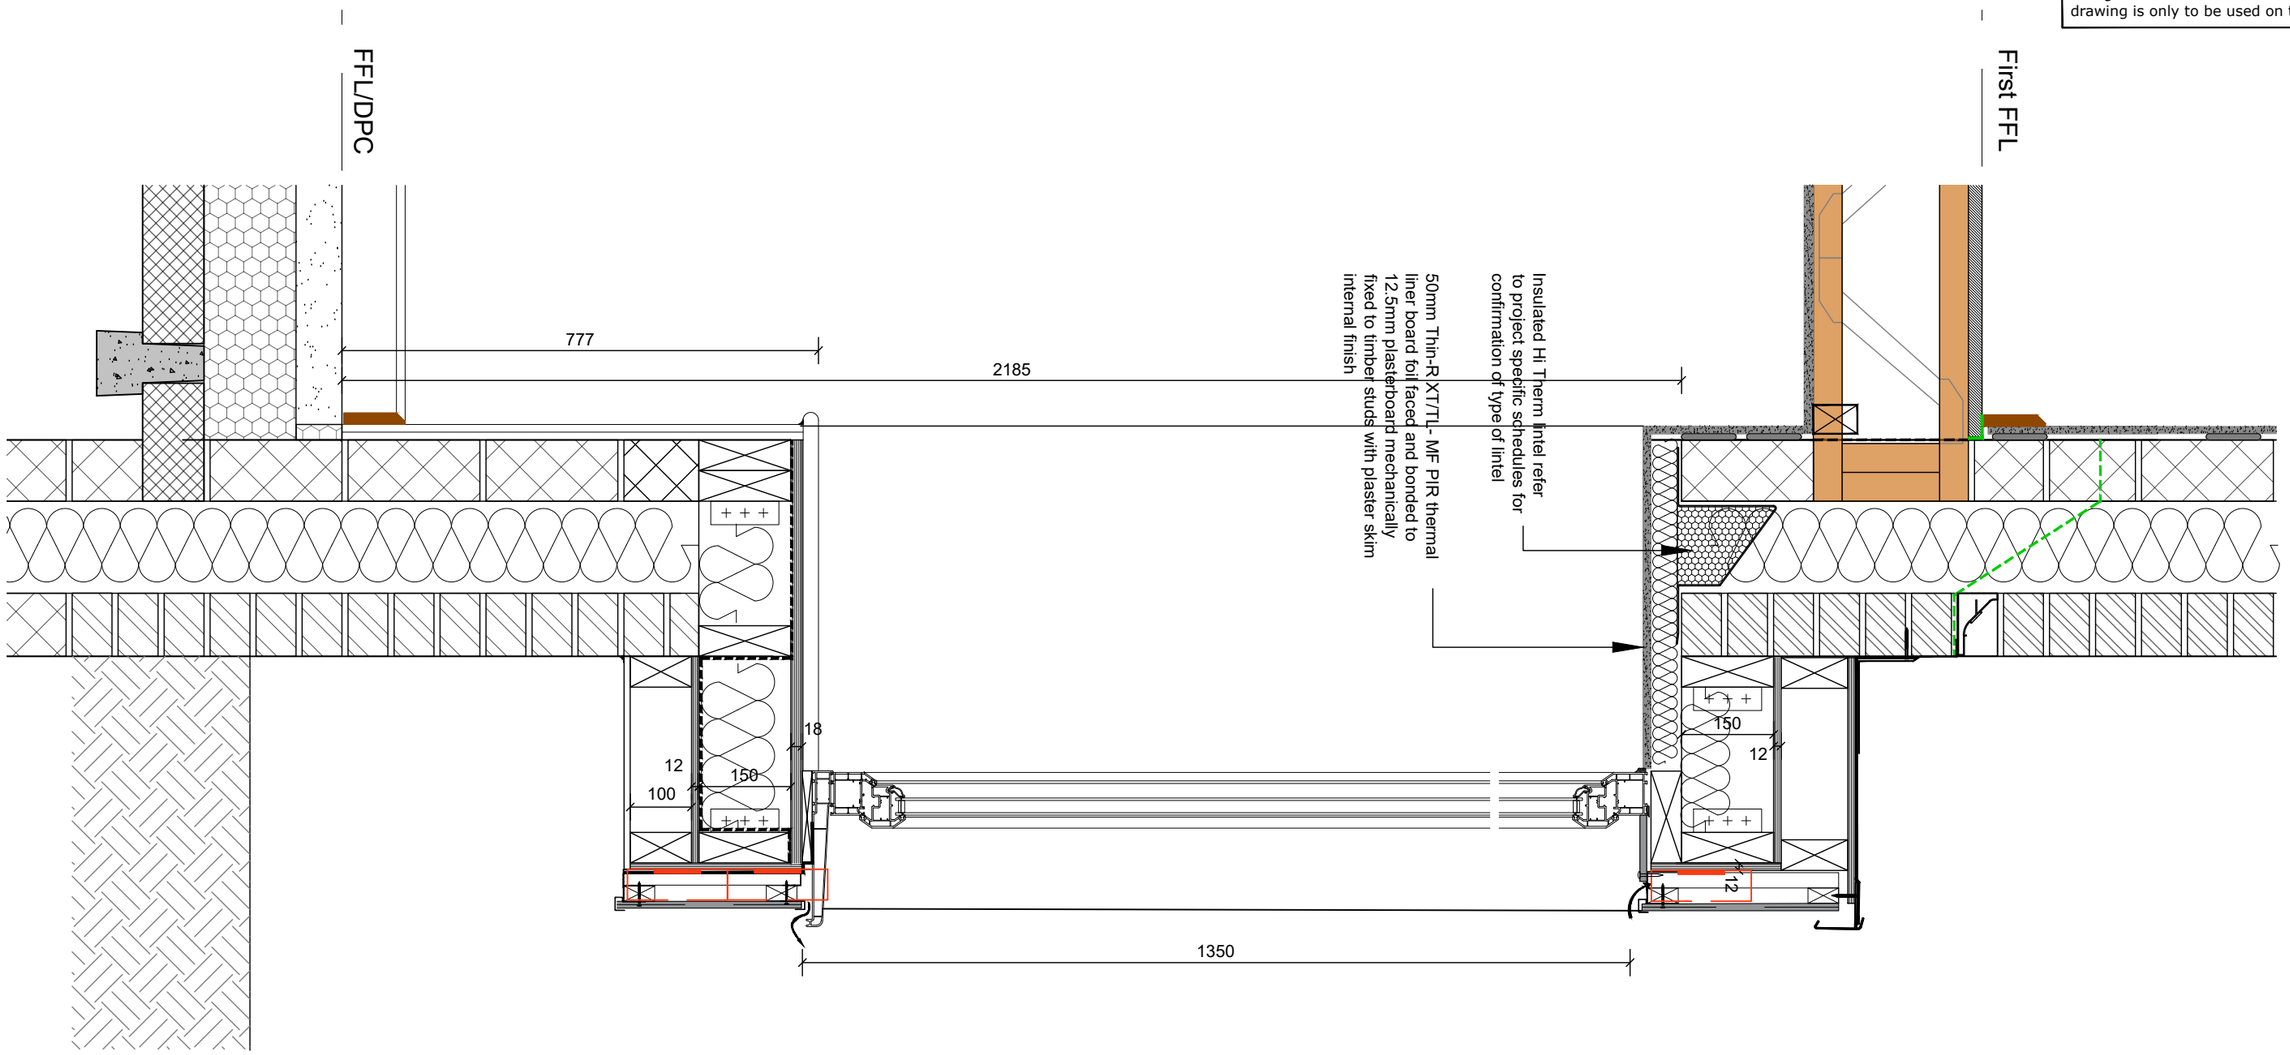

Rev.	Description.	Date.	Initial.
C2	Oriel roof updated to single ply membrane.	11.05.26	AK
C1	Construction Issue	04.03.26	NW

CONSTRUCTION

CURO GROUP

Standard House Type Collection

PROJECT
Bath Road, Keynsham P2

HOUSE TYPE
AVEBURY (Detached)

DRAWING TITLE
TYPICAL ORIEL WINDOW
SECTION B-B (TIMBER CLAD)

SCALE	DATE	AUTHOR	CHK'D
1:10 @A3	Feb 24	CB	AK

DRAWING NO.	REV
KEYN/AVE(D)/554	C2


NOTE: *This drawing is the copyright of Curo Group, All rights reserved. DO NOT scale from this drawing. This drawing is only to be used on the site for which specified

Movement joint & Reinforcement Legend

Vertical movement joint in accordance with Engineers details. Where possible to be 665mm from a corner. Where MJ is required less than 665mm refer to Engineers enhanced corner detail

FOR REINFORCEMENT REQUIREMENTS REFER TO STRUCTURAL ENGINEERS CALCULATIONS AND DRAWING 603

Solar PV shown as indicative only refer to specialist design for size & locations. Ensure 300mm clearance from array

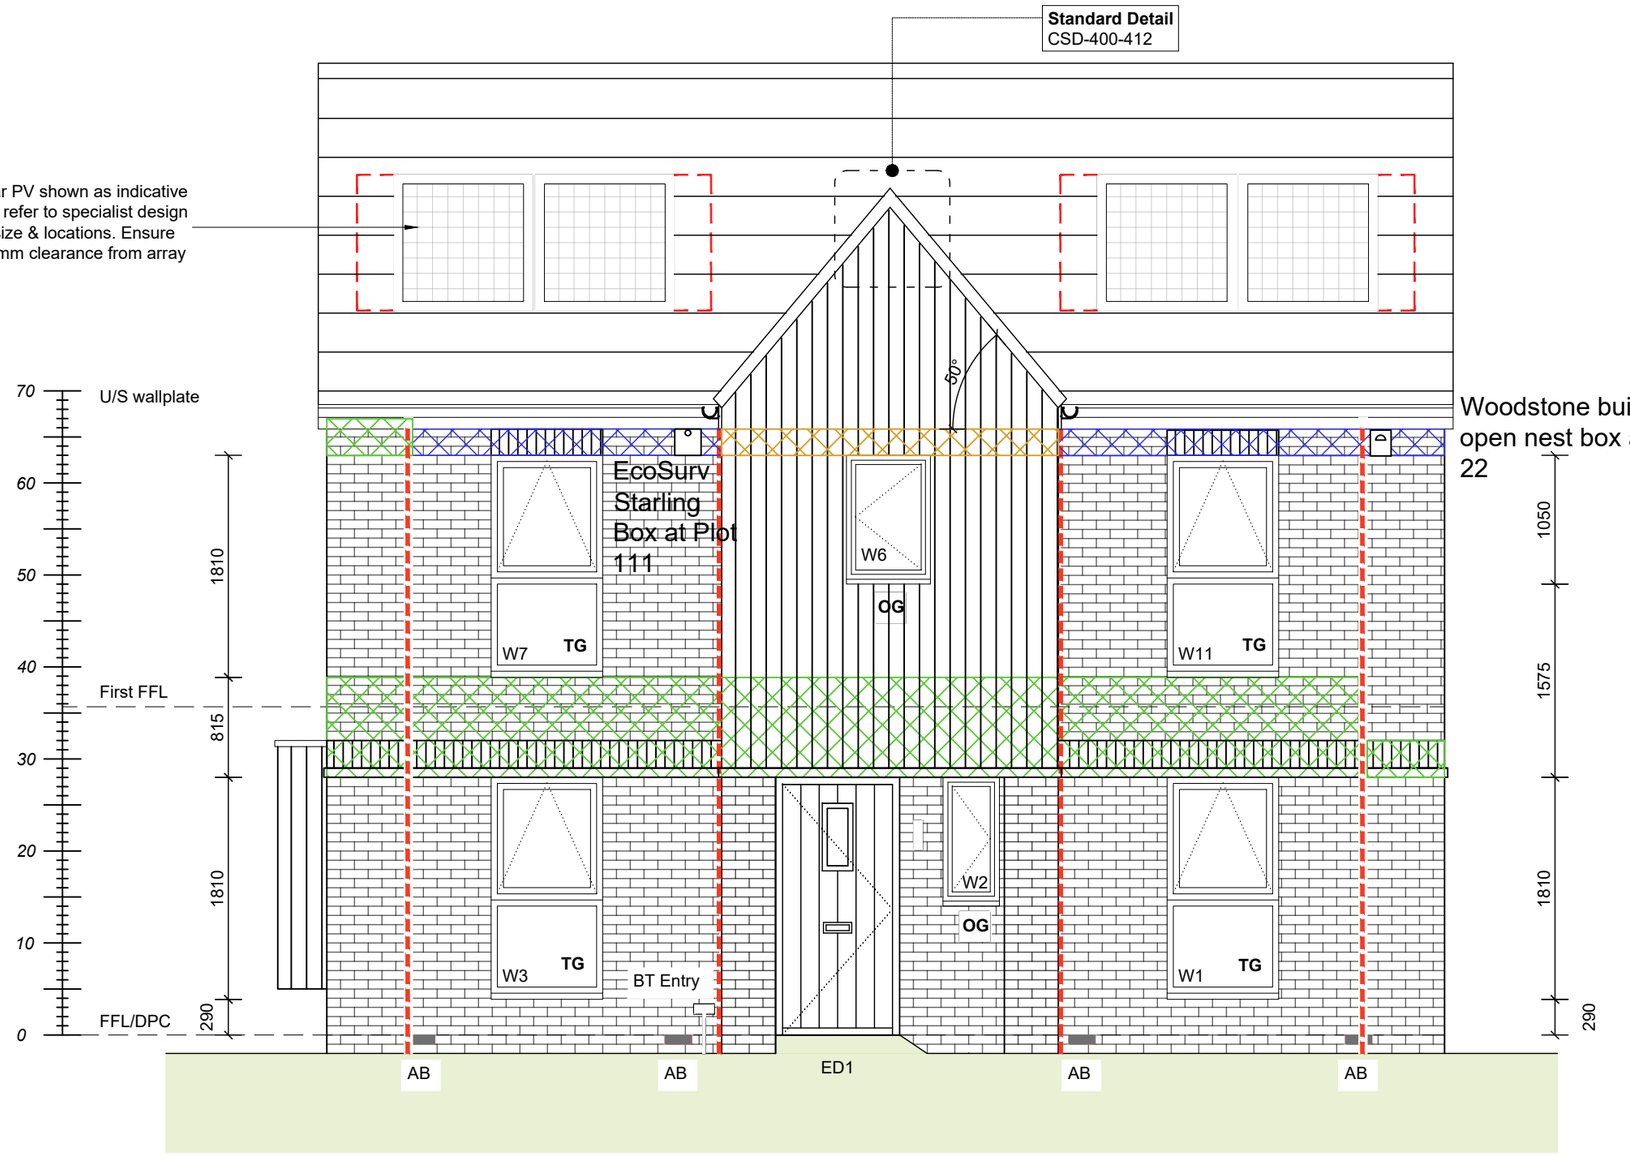

Key

TG	Toughened glazing
OG	Obscure glazing
EG	Escape window with guarding
FR	Fixed shut fire rated glazing

Tenure: Open Market

AS
Plots 29, 37, 111

OPP
Plots 1, 10, 22, 48, 119, 132, 206

Rev.	Description.	Date.	Initial.
C1	Construction Issue	04.03.26	NW
-	Superstructure Tender Issue	07.02.25	NS

CONSTRUCTION

CURO GROUP

Standard House Type Collection

PROJECT
Bath Road, Keynsham P2

HOUSE TYPE
AVEBURY (Detached)

DRAWING TITLE
FRONT ELEVATION
-

SCALE	DATE	AUTHOR	CHK'D
1:50 @A3	Feb 24	LB	AF

DRAWING NO.
KEYN/AVE(D)/600


REV
C1

NOTE: *This drawing is the copyright of Curo Group, All rights reserved. DO NOT scale from this drawing. This drawing is only to be used on the site for which specified

Movement joint & Reinforcement Legend

Vertical movement joint in accordance with Engineers details. Where possible to be 665mm from a corner. Where MJ is required less than 665mm refer to Engineers enhanced corner detail

FOR REINFORCEMENT REQUIREMENTS REFER TO STRUCTURAL ENGINEERS CALCULATIONS AND DRAWING 603

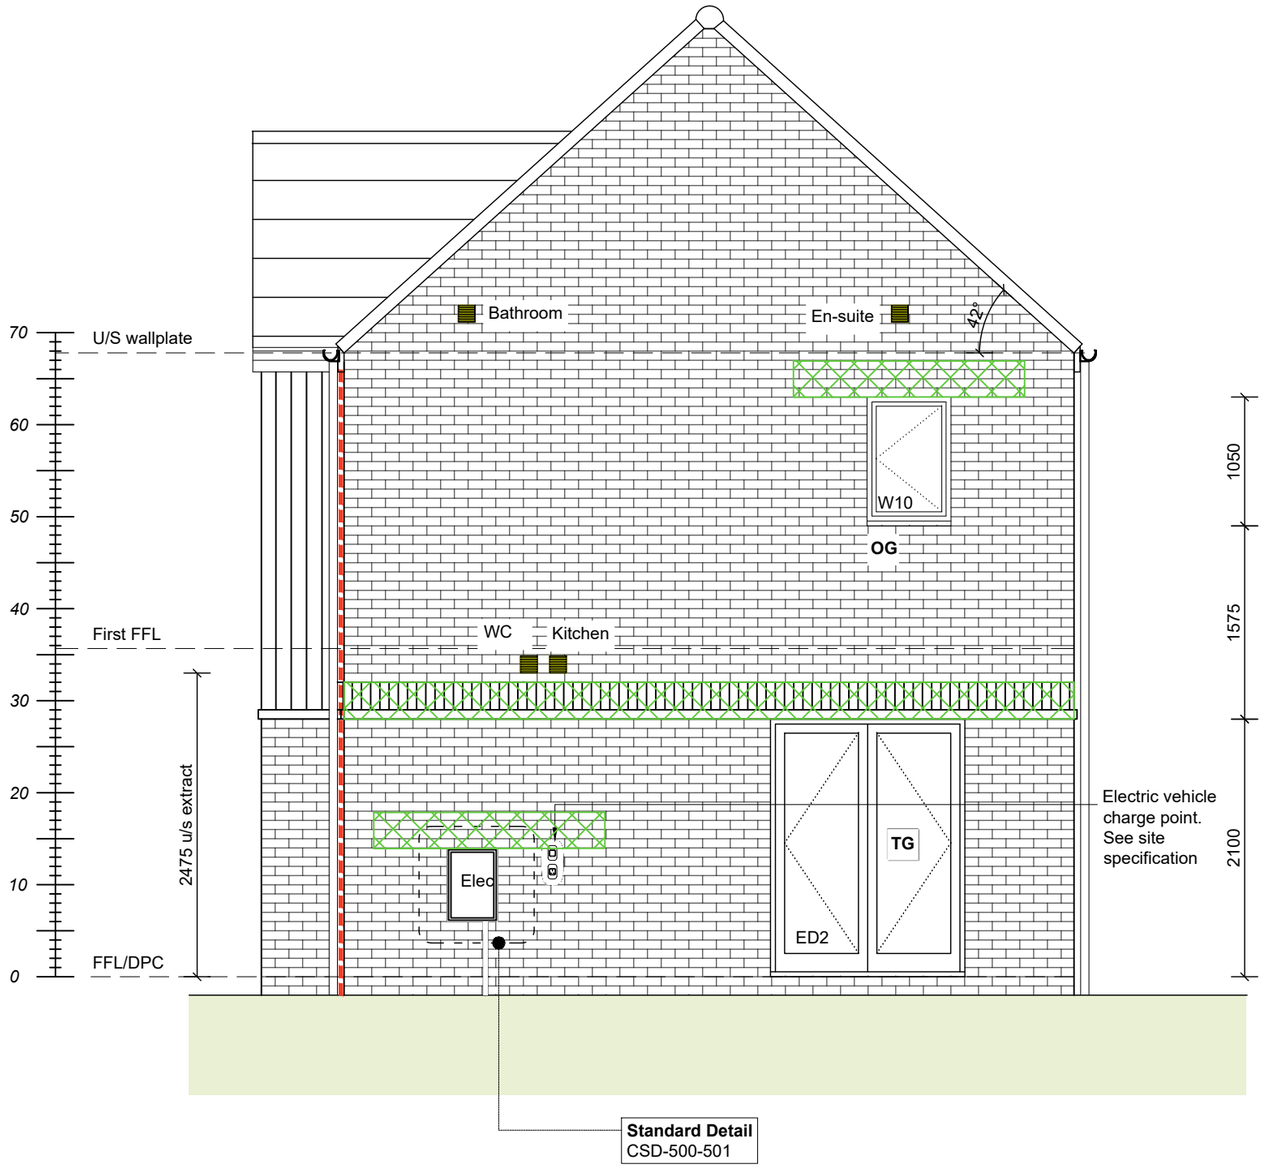

Key

TG	Toughened glazing
OG	Obscure glazing
EG	Escape window with guarding
FR	Fixed shut fire rated glazing

Tenure: Open Market

AS
Plots 29, 37, 111

OPP
Plots 1, 10, 22, 48, 119, 132, 206

Rev.	Description.	Date.	Initial.
C1	Construction Issue	04.03.26	NW
-	Superstructure Tender Issue	07.02.25	NS

CONSTRUCTION

CURO GROUP

Standard House Type Collection

PROJECT
Bath Road, Keynsham P2

HOUSE TYPE
AVEBURY (Detached)

DRAWING TITLE
SIDE ELEVATION
-

SCALE	DATE	AUTHOR	CHK'D
1:50 @A3	Feb 24	LB	AF

DRAWING NO.
KEYN/AVE(D)/601


REV
C1

NOTE: *This drawing is the copyright of Curo Group, All rights reserved. DO NOT scale from this drawing. This drawing is only to be used on the site for which specified

Movement joint & Reinforcement Legend

Vertical movement joint in accordance with Engineers details. Where possible to be 665mm from a corner. Where MJ is required less than 665mm refer to Engineers enhanced corner detail

FOR REINFORCEMENT REQUIREMENTS REFER TO STRUCTURAL ENGINEERS CALCULATIONS AND DRAWING 603

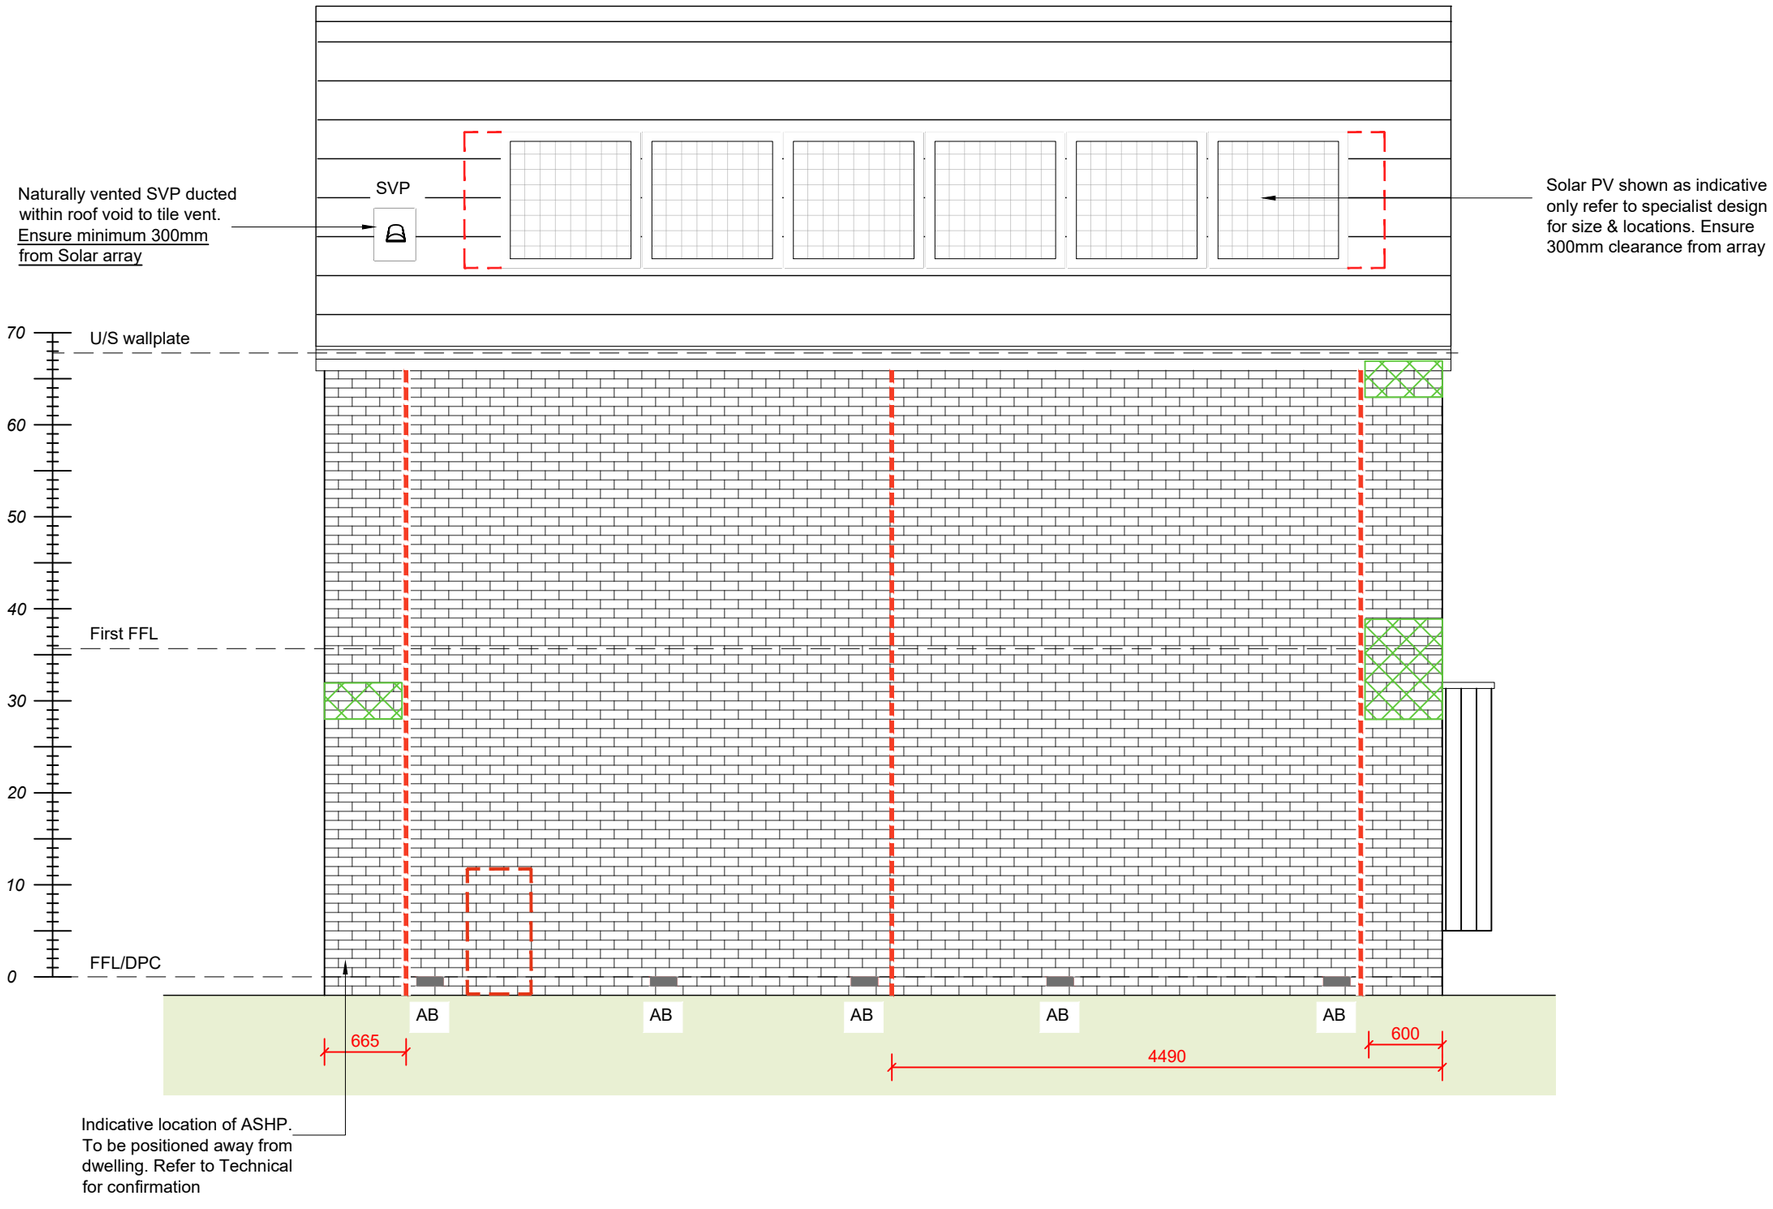

Key

TG	Toughened glazing
OG	Obscure glazing
EG	Escape window with guarding
FR	Fixed shut fire rated glazing

Tenure: Open Market

AS
Plots 29, 37, 111

OPP
Plots 1, 10, 22, 48, 119, 132, 206

Rev.	Description.	Date.	Initial.
C1	Construction Issue	04.03.26	NW
-	Superstructure Tender Issue	07.02.25	NS

CONSTRUCTION

CURO GROUP

Standard House Type Collection

PROJECT
Bath Road, Keynsham P2

HOUSE TYPE
AVEBURY (Detached)

DRAWING TITLE
REAR ELEVATION
-

SCALE	DATE	AUTHOR	CHK'D
1:50 @A3	Feb 24	LB	AF

DRAWING NO.
KEYN/AVE(D)/602


REV
C1

NOTE: *This drawing is the copyright of Curo Group, All rights reserved. DO NOT scale from this drawing. This drawing is only to be used on the site for which specified

Movement joint & Reinforcement Legend

Vertical movement joint in accordance with Engineers details. Where possible to be 665mm from a corner. Where MJ is required less than 665mm refer to Engineers enhanced corner detail

FOR REINFORCEMENT REQUIREMENTS REFER TO STRUCTURAL ENGINEERS CALCULATIONS AND DRAWING 603

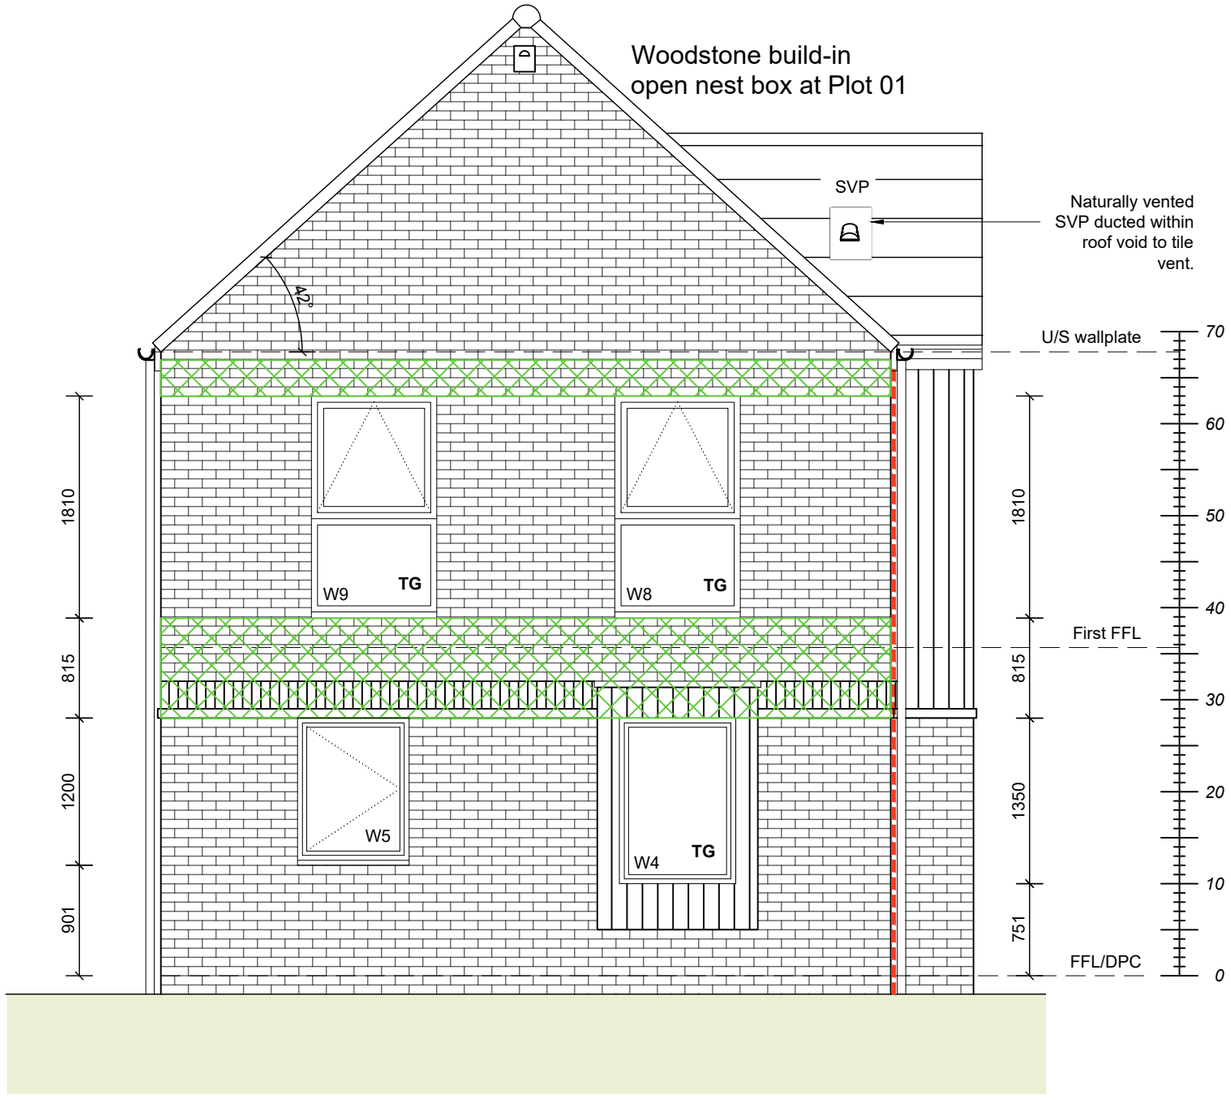

Key

TG	Toughened glazing
OG	Obscure glazing
EG	Escape window with guarding
FR	Fixed shut fire rated glazing

Tenure: Open Market

AS
Plots 29, 37, 111

OPP
Plots 1, 10, 22, 48, 119, 132, 206

Rev.	Description.	Date.	Initial.
C1	Construction Issue	04.03.26	NW
-	Superstructure Tender Issue	07.02.25	NS

CONSTRUCTION

CURO GROUP

Standard House Type Collection

PROJECT
Bath Road, Keynsham P2

HOUSE TYPE
AVEBURY (Detached)

DRAWING TITLE
SIDE ELEVATION


-


SCALE	DATE	AUTHOR	CHK'D
1:50 @A3	Feb 24	LB	AF


DRAWING NO.
KEYN/AVE(D)/603


REV
C1

NOTE: *This drawing is the copyright of Curo Group, All rights reserved. DO NOT scale from this drawing. This drawing is only to be used on the site for which specified

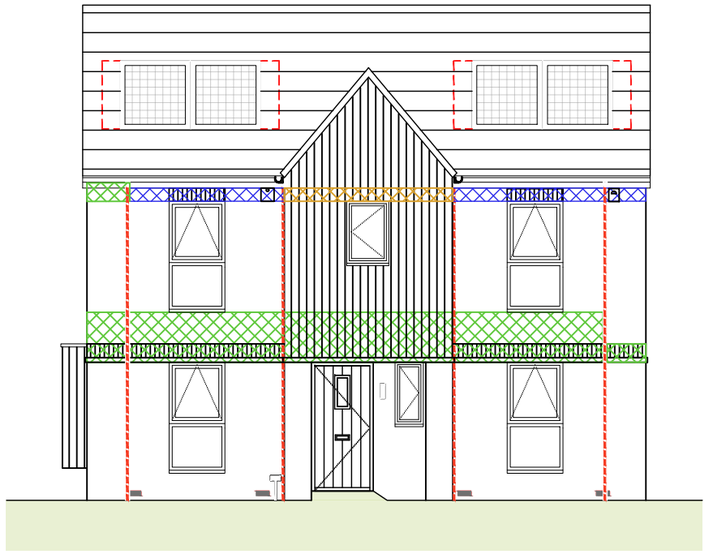

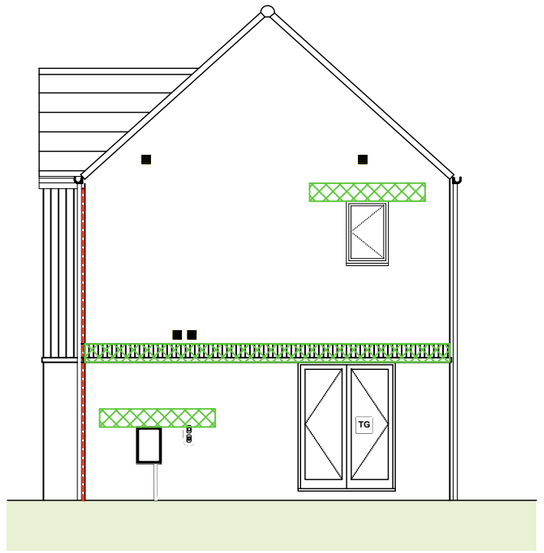

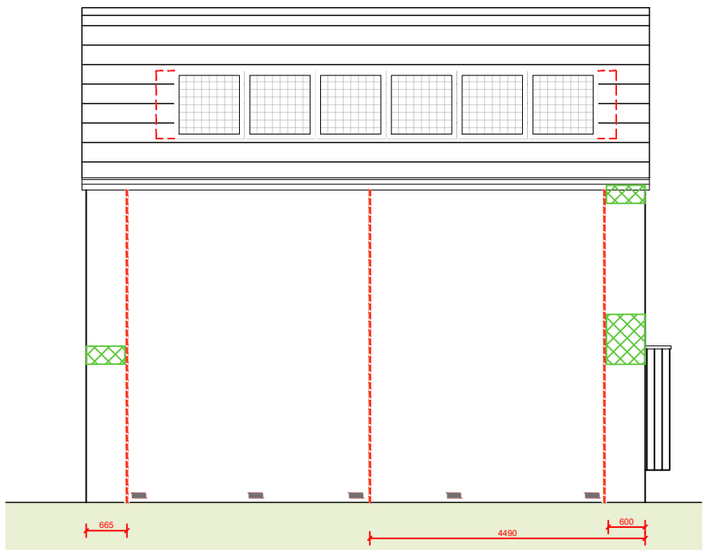

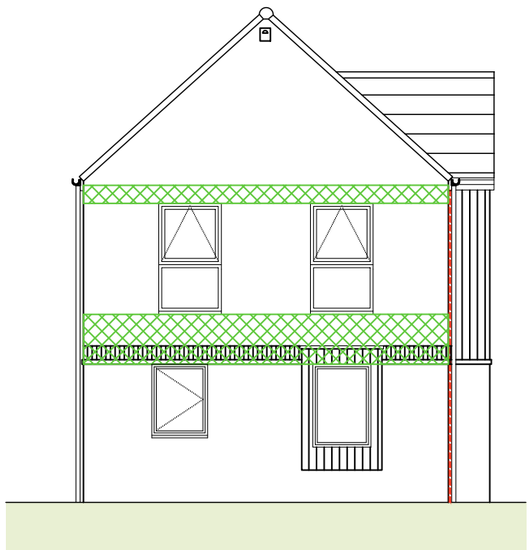

Legend

Green hatch indicates bed joint reinforcement SBF 30W60 Brick force reinforcement in every second course. Additionally same specification of bed joint reinforcement is required at 150 vertical c/c in 3 course above openings with 600mm reveals as well as above soldier courses.

Orange hatch indicates bed joint reinforcement SBF 30W60 Brick force reinforcement at 75 vertical c/c in 3 courses above openings with 600mm reveals is required.

Blue hatch indicates bed joint reinforcement SBF 30W60 Brick force reinforcement below and above soldier course with 600mm reveals is required.

Vertical movement joint 10mm wide in external leaf of masonry

ALL TO BE READ IN CONJUNCTION WITH STRUCTURAL ENGINEERS DESIGN & CALCULATIONS

Tenure: Open Market

AS
Plots 29, 37, 111

OPP
Plots 1, 10, 22, 48, 119, 132, 206

Rev.	Description.	Date.	Initial.
C1	Construction Issue	04.03.26	NW
-	Superstructure Tender Issue	07.02.25	NS

CONSTRUCTION

CURO GROUP

Standard House Type Collection

PROJECT
Bath Road, Keynsham P2

HOUSE TYPE
AVEBURY (Detached)


DRAWING TITLE
BRICK REINFORCEMENT REQUIREMENTS

SCALE	DATE	AUTHOR	CHK'D
1:100 @A3	Feb 24	LB	AF

DRAWING NO.
KEYN/AVE(D)/604

REV
C1

NOTE: *This drawing is the copyright of Curo Group, All rights reserved. DO NOT scale from this drawing. This drawing is only to be used on the site for which specified

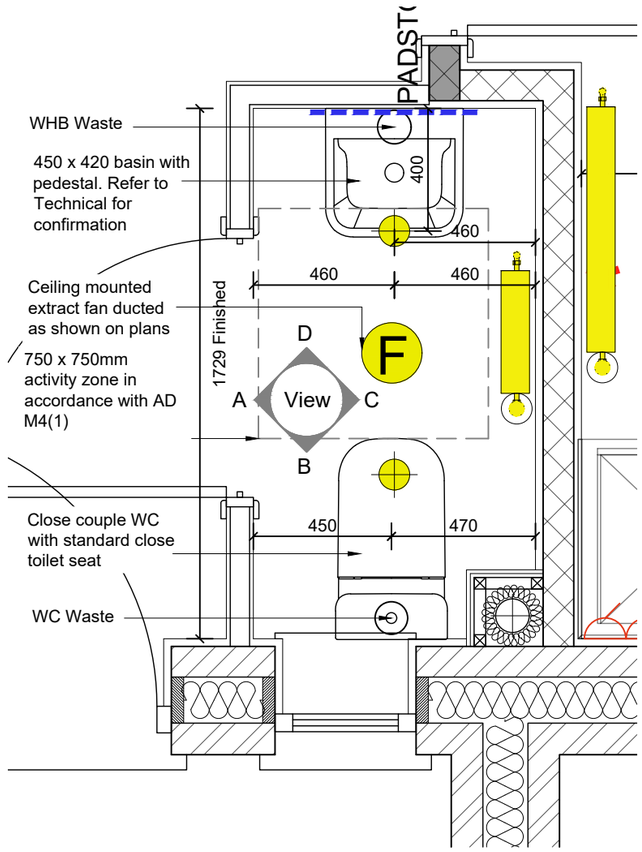


Key


- 1 course tiled splashback
- Extent of full height tiling
- Extent of half height tiling
- Extent of drainage

U/L — 6mm Plywood underlayment to Bathroom floor fixed at 100mm centres to receive floor tiling


To be read in conjunction with Curo internal finishes spec

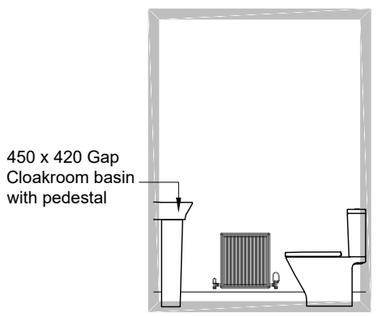


WC ELEVATION A

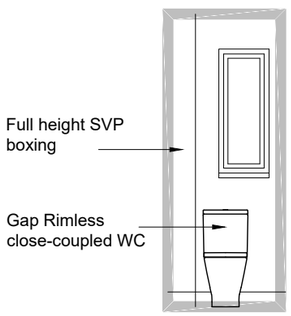

WC ELEVATION B

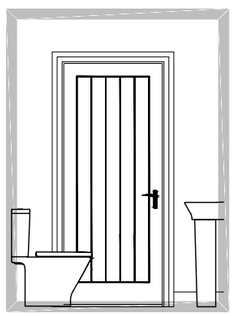

WC ELEVATION C

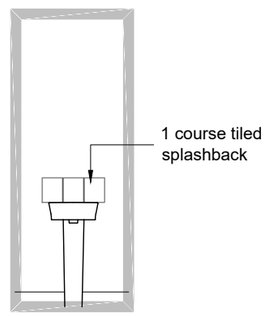

WC ELEVATION D

Rev.	Description.	Date.	Initial.
C1	Construction Issue	04.03.26	NW
-	Superstructure Tender Issue	07.02.25	NS

CONSTRUCTION

CURO GROUP

Standard House Type Collection

PROJECT
Bath Road, Keynsham P2

HOUSE TYPE
AVEBURY (Detached)


DRAWING TITLE
WC LAYOUT
-

SCALE	DATE	AUTHOR	CHK'D
1:20 @A3	Feb 24	LB	AF

DRAWING NO.
KEYN/AVE(D)/700

REV
C1


NOTE: *This drawing is the copyright of Curo Group, All rights reserved. DO NOT scale from this drawing. This drawing is only to be used on the site for which specified

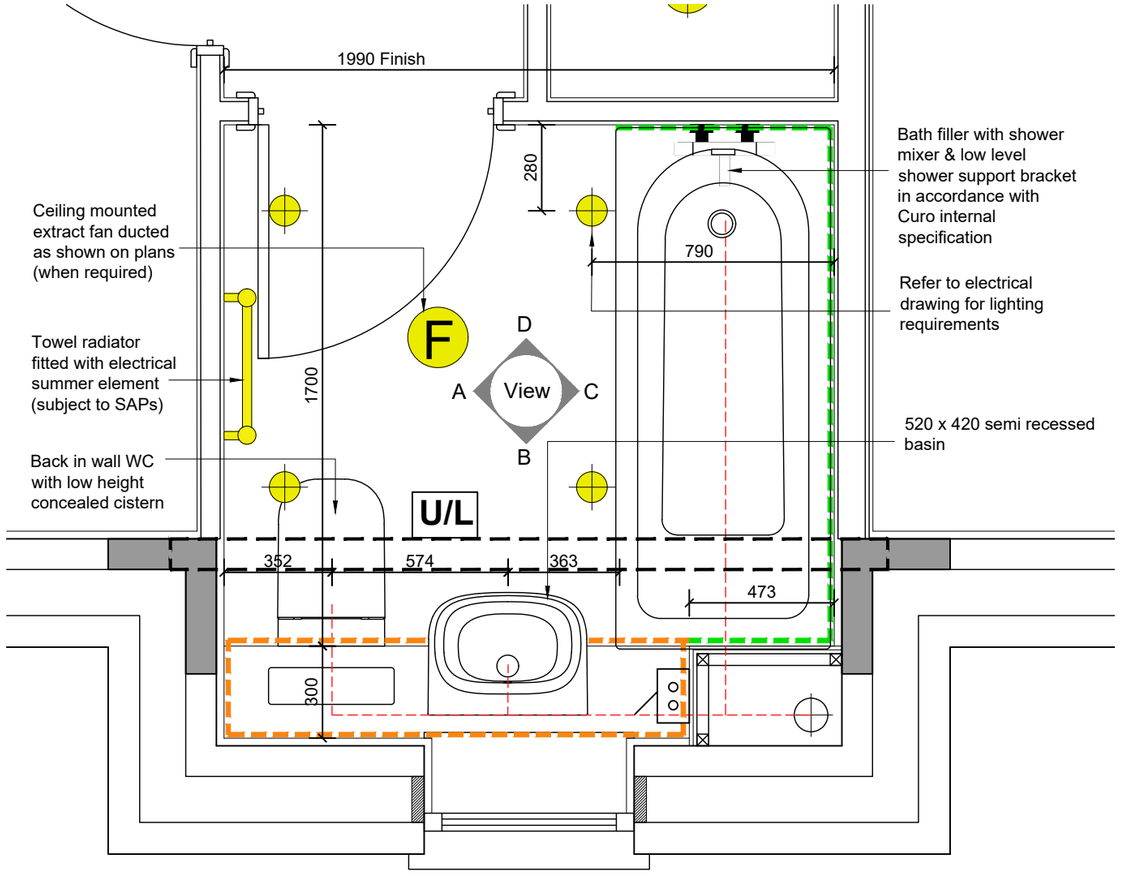


Key

- 1 course tiled splashback
- Extent of full height tiling
- Extent of half height tiling
- Extent of drainage
- U/L — 6mm Plywood underlayment to Bathroom floor fixed at 100mm centres to receive floor tiling


To be read in conjunction with Curo internal finishes spec

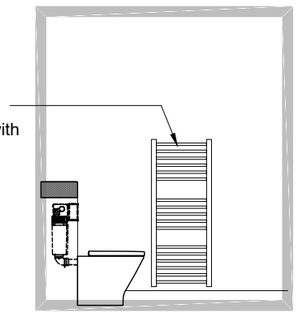


BATHROOM ELEVATION A

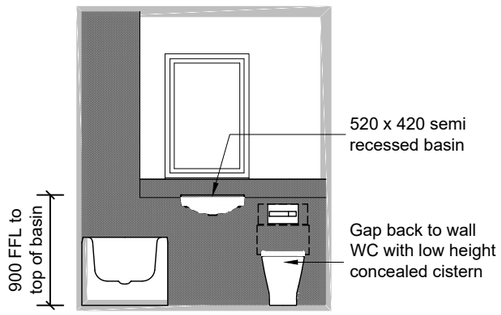

BATHROOM ELEVATION B

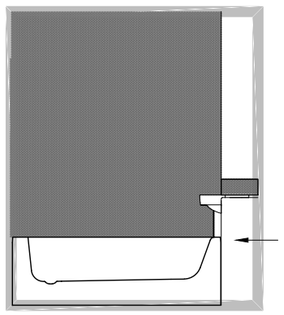

BATHROOM ELEVATION C

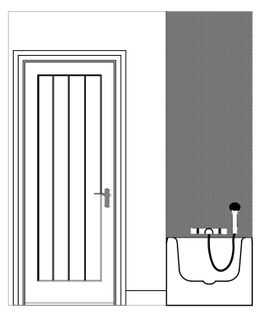

BATHROOM ELEVATION D

Hatching indicates extent of tiling in accordance with Curo internal specification

Rev.	Description.	Date.	Initial.
C1	Construction Issue	04.03.26	NW
-	Superstructure Tender Issue	07.02.25	NS

CONSTRUCTION

CURO GROUP

Standard House Type Collection

PROJECT
Bath Road, Keynsham P2

HOUSE TYPE
AVEBURY (Detached)


DRAWING TITLE
BATHROOM LAYOUT
-


SCALE	DATE	AUTHOR	CHK'D
1:20 @A3	Feb 24	LB	AF

DRAWING NO.
KEYN/AVE(D)/701


REV
C1

NOTE: *This drawing is the copyright of Curo Group, All rights reserved. DO NOT scale from this drawing. This drawing is only to be used on the site for which specified

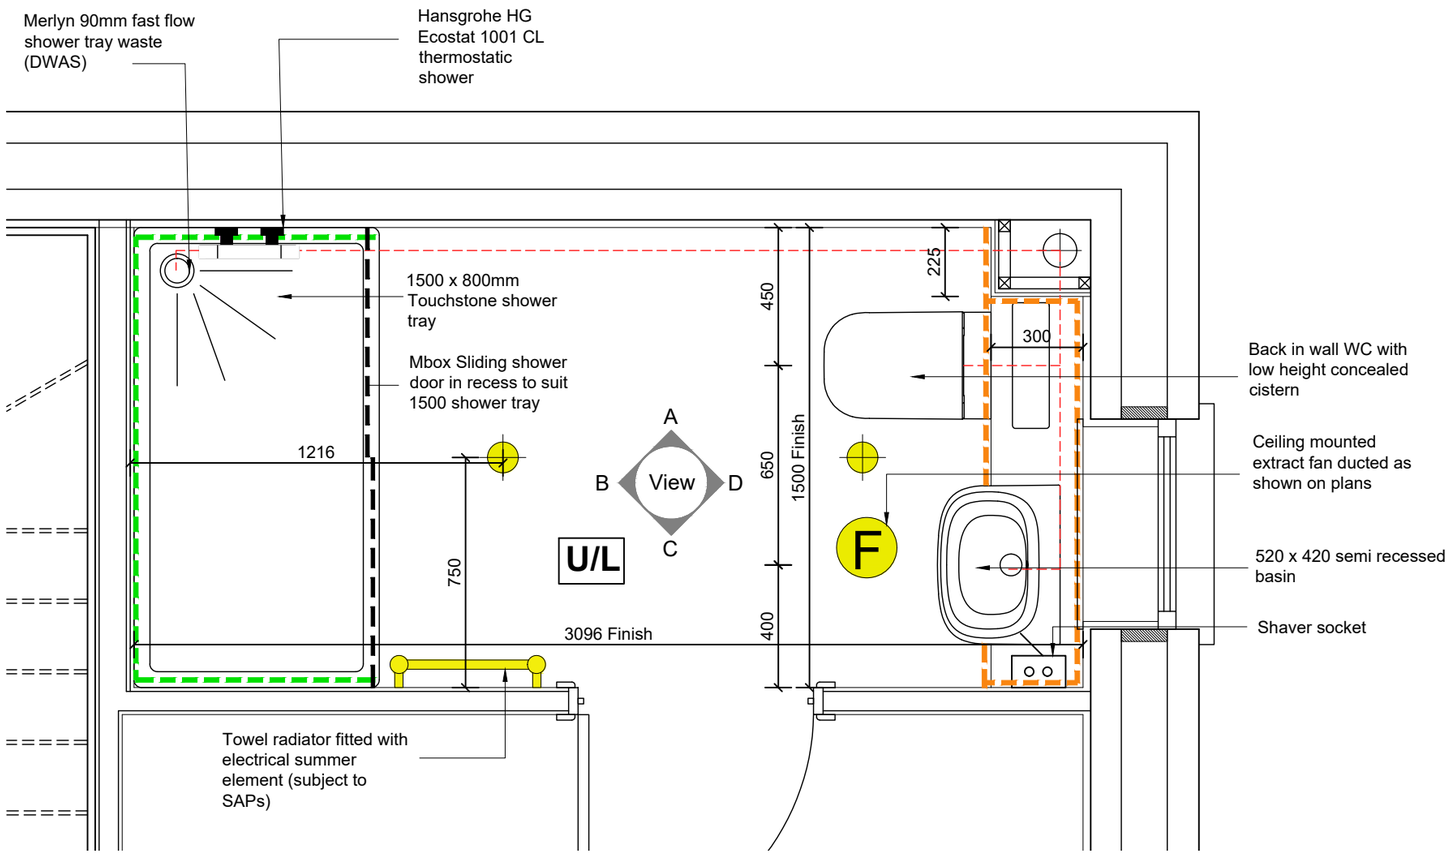


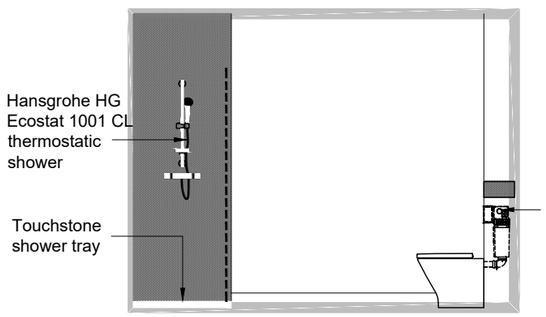


BATHROOM ELEVATION A

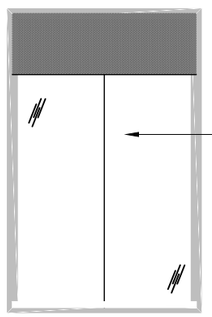

BATHROOM ELEVATION B

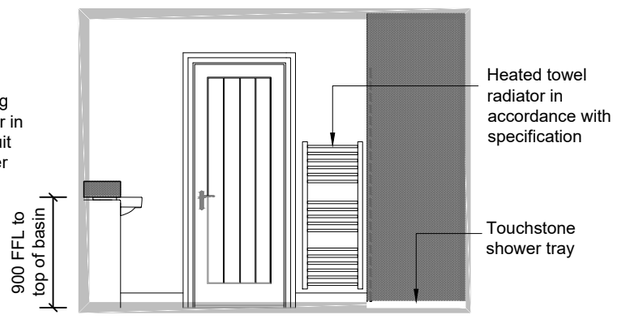

BATHROOM ELEVATION C

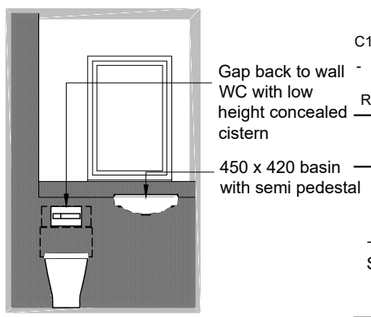

BATHROOM ELEVATION D

Hatching indicates extent of tiling in accordance with Curo internal specification

Key

- 1 course tiled splashback
- Extent of full height tiling
- Extent of half height tiling
- Extent of drainage
- U/L — 6mm Plywood underlayment to Bathroom floor fixed at 100mm centres to receive floor tiling

To be read in conjunction with Curo internal finishes spec

Rev.	Description.	Date.	Initial.
C1	Construction Issue	04.03.26	NW
-	Superstructure Tender Issue	07.02.25	NS

CONSTRUCTION

CURO GROUP

Standard House Type Collection

PROJECT
Bath Road, Keynsham P2

HOUSE TYPE
AVEBURY (Detached)


DRAWING TITLE
EN-SUITE LAYOUT
-

SCALE	DATE	AUTHOR	CHK'D
1:20 @A3	Feb 24	LB	AF

DRAWING NO.
KEYN/AVE(D)/702

REV
C1


NOTE: *This drawing is the copyright of Curo Group, All rights reserved. DO NOT scale from this drawing. This drawing is only to be used on the site for which specified

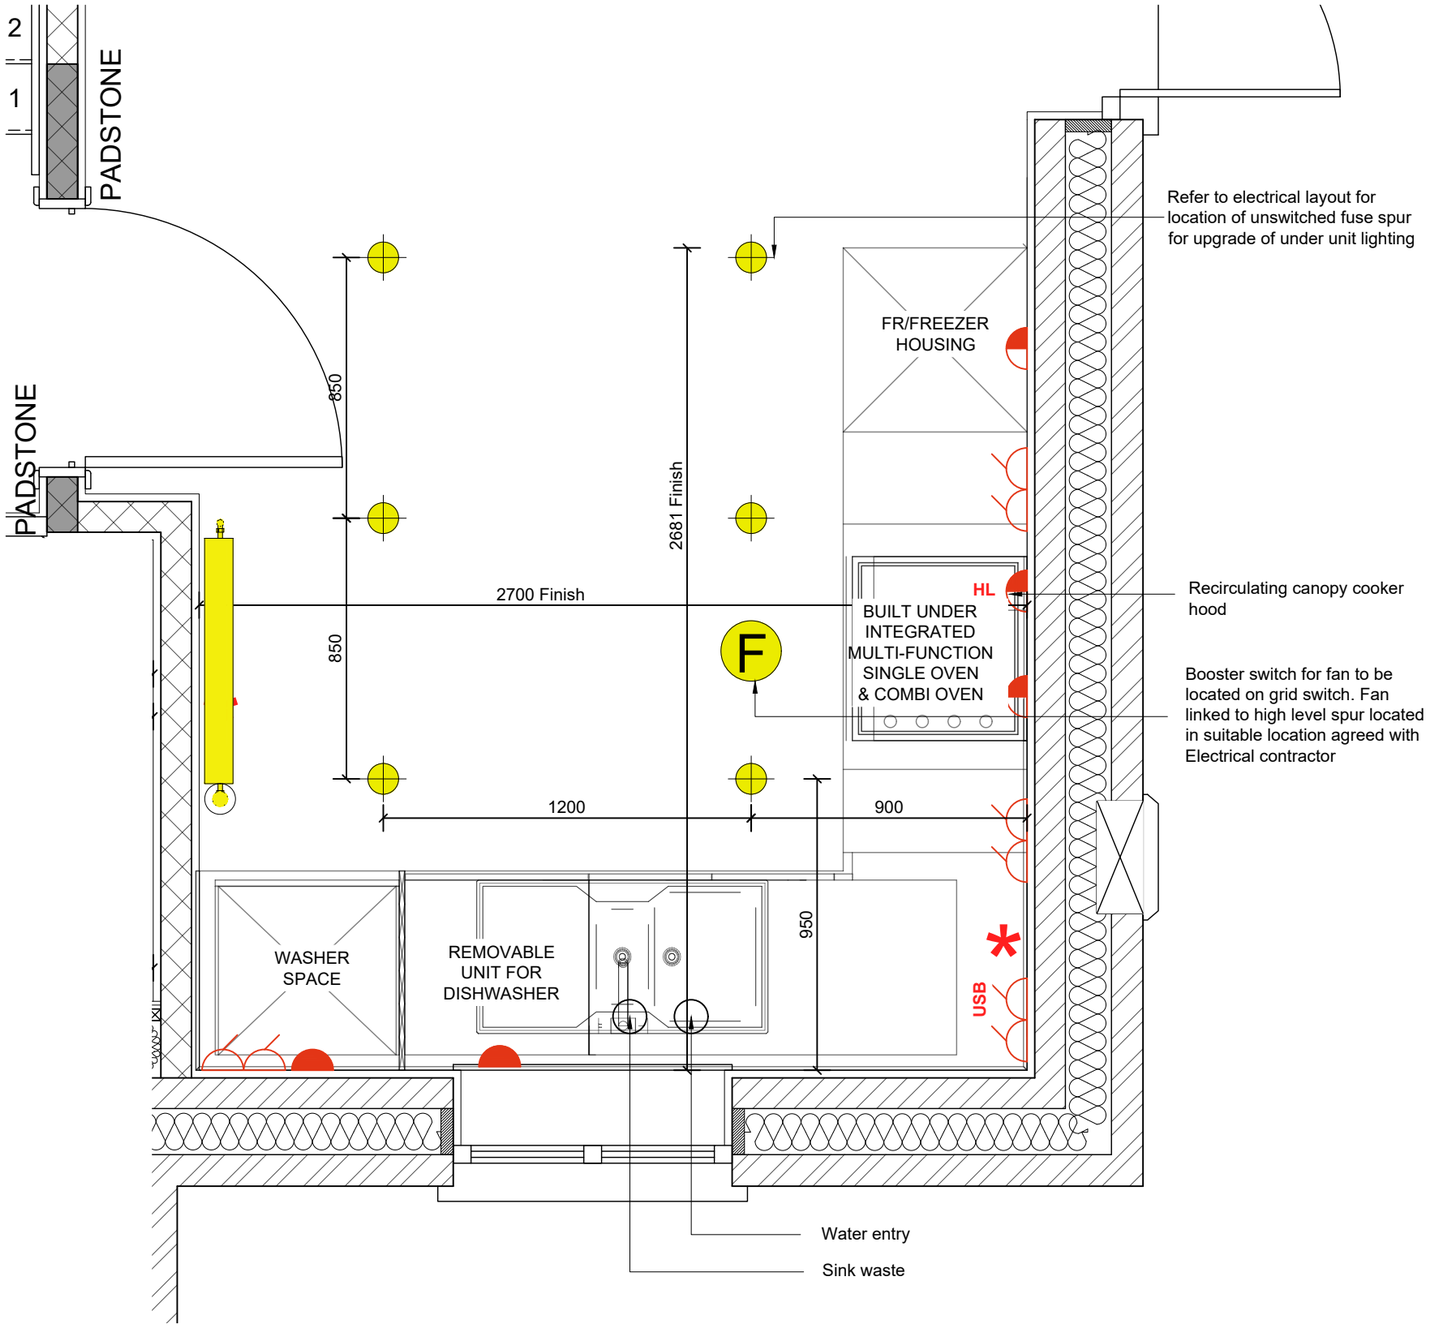


Electrical Legend

- 13A unswitched single socket at low level. Linked to grid switch
- USB — 13A double switched socket outlet above worktop with 2 integral USB ports
- 13A double switched socket outlet above worktop
- HL — 13A unswitched high level flex outlet plate linked to grid switch
- Unswitched flex outlet plate for oven / hob linked to grid switch
- * Multi grid appliance switch

Electrical fittings near cookers & sinks

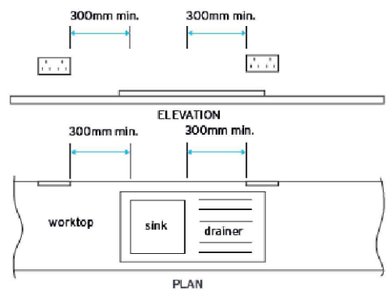

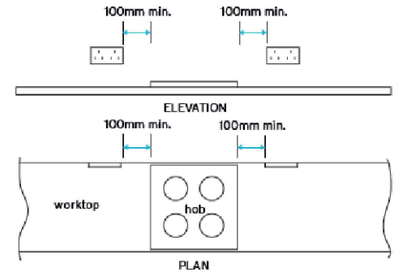

NOTE: REFER TO FINISHING SPECIFICATION FOR EXACT KITCHEN FINISHES COMPLIANCE

Rev.	Description.	Date.	Initial.
C2	Oven note added as per client comments	16.04.26	NW
C1	Construction Issue	04.03.26	NW
-	Superstructure Tender Issue	07.02.25	NS

CONSTRUCTION

CURO GROUP

Standard House Type Collection

PROJECT
Bath Road, Keynsham P2

HOUSE TYPE
AVEBURY (Detached)

DRAWING TITLE
KITCHEN LAYOUT
-

SCALE	DATE	AUTHOR	CHK'D
1:20 @A3	Feb 24	LB	AF

DRAWING NO.
KEYN/AVE(D)/703

REV
C2

NOTE: *This drawing is the copyright of Curo Group, All rights reserved. DO NOT scale from this drawing. This drawing is only to be used on the site for which specified

External Opening Schedule

Opening Reference	Location	Structural opening (w x h)	Lintel size / Type	Minimum equivalent area of background ventilators	Requirements	Part K Guarding Requirements	Finished floor to finished cill (25mm cill thickness)	Finished cill to finished transom acting as guarding
OP - 01	External Lobby	1866 x 2100	2250 Heavy Duty	N/A	N/A	N/A	N/A	N/A
ED1	Hall	1012 x 2100	1350	N/A	PAS 24 Level threshold	N/A	N/A	N/A
ED2	Dining	1585 x 2100	1950	min 4000mm²	PAS 24, Toughened	N/A	N/A	N/A
W1	Kitchen	910 x 1810	1200	N/A	PAS 24, Toughened	N/A	365mm	835mm
W2	Kitchen	460 x 910	750	N/A	PAS 24, Obscure	N/A	1075mm	55mm
W3	Living	910 x 1810	1200	min 4000mm²	PAS 24, Toughened	N/A	315mm	835mm
W4	Living	950 x 1350	1200	min 4000mm²	Toughened	N/A	775mm	fixed glazing
W5	Living	910 x 1200	1200	min 4000mm²	N/A	N/A	925mm	55mm
W6	Bathroom	685 x 1050	1050	N/A	Obscure	N/A	1025mm	55mm
W7	Bedroom 2	910 x 1810	1200 Heavy Duty	min 4000mm²	Escape, Toughened	N/A	265mm	835mm
W8	Bedroom 2	1023 x 1810	1350	min 4000mm²	Toughened	N/A	265mm	835mm
W9	Bedroom 3	1023 x 1810	1350	min 4000mm²	Toughened	N/A	265mm	835mm
W10	En-suite	685 x 1050	900	N/A	Obscure	N/A	1025mm	55mm
W11	Bedroom 1	910 x 1810	1200 Heavy Duty	min 4000mm²	Escape, Toughened	N/A	265mm	835mm
Meter	N/A	365 x 535	750	N/A	N/A	N/A	N/A	N/A

Total background ventilation 24,0000mm² Total vents = 6 (minimum of 5 required)

FOR LINTEL TYPES REFER TO MANUFACTURERS SCHEDULES

Internal Opening Schedule

Opening Reference	Location	Door size	Structural opening (w x h)	o/a Wall thickness	Lintel size / type	Requirements
D1	Living	838 x 1981	906 x 2032	158mm	BOX 1200	Lining increased to allow for 20mm dabs to one side
D2	Under stair Store	686 x 1981	754 x 2032	114mm	N/A - Studwork	-
D3	Kitchen	838 x 1981	906 x 2032	150mm	R15A 100x140dp Stressline prestressed concrete lintel	
D4	WC	838 x 1981	906 x 2032	88mm	N/A - Studwork	-
D5	Bed 3	762 x 1981	830 x 2032	114mm	N/A - Studwork	-
D6	Bed 2	762 x 1981	830 x 2032	88mm	N/A - Studwork	-
D7	Bathroom	762 x 1981	830 x 2032	88mm	N/A - Studwork	-
D8	Store	686 x 1981	754 x 2032	88mm	N/A - Studwork	-
D9	Bed 1	762 x 1981	830 x 2032	88mm	N/A - Studwork	
D10	En-suite	762 x 1981	830 x 2032	88mm	N/A - Studwork	-

Ensure 10mm undercut to all doors above finished surface of floor. If floor finish is not fitted unsure undercut of 20mm above unfinished floor level
Structural opening widths based on 25mm lining with total 18mm tolerance
20mm dabs allowed for on 100mm block walls to side where radiators fitted with 12.5mm plasterboard finish
75mm thick buttress studs lined to one side with 12.5mm plywood plus 2 layers 12.5mm plasterboard

Continuous Mechanical Extract Ventilation

Background ventilation criteria system 3 (continuous) rates in accordance with table 1.2 approved document f (f1). the total trickle ventilation equivalent minimum area (mm sq) required for each room for use with continuous extract fans is given below:

Habitable room = min 4000mm² (where noted on schedules)
Wet room = not required

Provide a minimum total number of ventilators that is the same as the number of bedrooms plus two ventilators (i.e. two bedroom dwelling should have 4 background ventilators all in accordance with paragraph 1.64 c.

Table 1.2 Minimum extract ventilation rates for continuous extract systems[1]

Room	High rate (l/s)	Continuous rate
Kitchen	13	The sum of all extract ventilation in the dwelling on its continuous rate should be at least the whole dwelling ventilation rate given in Table 1.3
Utility room	8	
Bathroom	8	
Sanitary accommodation	6	

NOTE:
1. If the continuous rate of ventilation provided in a room is equal to or higher than the minimum high rate specified in the table, no extra ventilation is needed.

Rev.	Description.	Date.	Initial.
C2	W2, W10 lintel size and D5 reviewed and amended.	27.04.26	NW
C1	Construction Issue	04.03.26	NW
-	Superstructure Tender Issue	07.02.25	NS

CONSTRUCTION

CURO GROUP

Standard House Type Collection

PROJECT
Bath Road, Keynsham P2

HOUSE TYPE
AVEBURY (Detached)

DRAWING TITLE
WINDOW / DOOR SCHEDULES
-

SCALE	DATE	AUTHOR	CHK'D
N/A @A3	Feb 24	LB	AF


DRAWING NO. KEYN/AVE(D)/800

REV C2

NOTE: *This drawing is the copyright of Curo Group, All rights reserved. DO NOT scale from this drawing. This drawing is only to be used on the site for which specified

Electrical Legend

S	Ceiling mounted smoke detector
HD	Ceiling mounted heat detector
F	Ceiling mounted extract fan
	Wall mounted extract fan
P	Pendant light fitting
	Downlighters
B	Batten light
	External light PIR
1 2 3	1 gang 1 way switch 1 gang 2 way switch 1 gang 3 way switch
R	Remote test / silent button for smoke detector in loft space
	13A switched double socket at low level
USB	13A switched double socket with USB at low level
MEDIA	Media plate (TV, FM, DAB, Data, SAT (2), BT, Double sockets (2)
	Shaver socket
	Telephone point
	Coaxial cable
	Door bell
	Door bell sounder
	Fused spur to extract fans and cylinder
BA	Unswitched fused spur for upgrade of wireless alarm
CL	Unswitched fused spur for upgrade of under cabinet lighting
	Blanking plate
	Outside tap
	BT Entry
	Thermostat
ONT	Fibre to the premises, with twin switched socket outlet installed next to FTTP socket. ONT box to be installed adjacent to the outside wall (as per Option 1 of Openreach Developer Guide).
CONSUMER	Consumer unit

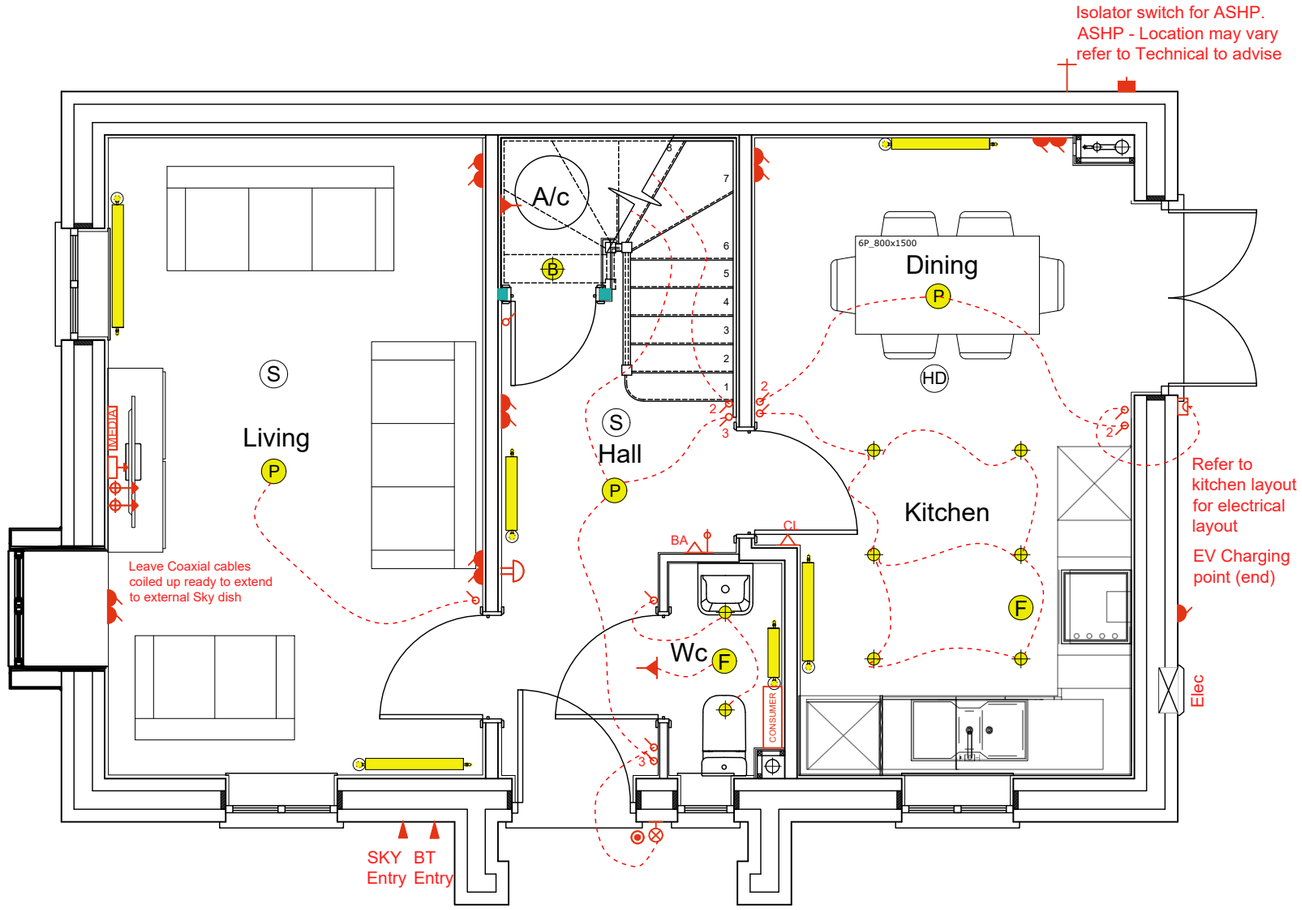

Notes

Electrical layout to be read in strict accordance with Curo internal specification

Switches & sockets, including door bells, entry phones, light switches, power sockets, TV aerials and telephone jacks, serving habitable rooms throughout the dwelling have their centre line 450-1200mm above floor level in accordance with AD M4(1) Diagram 1.5.

Consumer units to be mounted so that the switches are 1350-1450mm above FFL

Where M4(2) compliant requirements above to be met however sockets to installed minimum 300mm (measured horizontally) from an inside corner. AD M4(2) 2.30. Locate these sockets min 400mm from internal corner to centre line of socket

Any boiler timer controls & Thermostats to be mounted between 900mm and 1200mm above FFL. AD M4(2) 2.30

Number of socket outlets to meet NHBC standards as stated below and in accordance with NHBC 8.1.7 Table 6:

Kitchen = 8
Living / Family = 8 (minimum of 2 outlets near the TV aerial unit)
Bedrooms = 6 (4) (Minimum of 6 outlets for the main bedroom & minimum of 4 outlets for other bedrooms
Dining room = 4
Landing = 2
Hall = 2

Tenure: Open Market

AS
Plots 29, 37, 111

OPP
Plots 1, 10, 22, 48, 119, 132, 206

Rev.	Description.	Date.	Initial.
C1	Construction Issue	04.03.26	NW
-	Superstructure Tender Issue	07.02.25	NS

CONSTRUCTION

CURO GROUP

Standard House Type Collection

PROJECT
Bath Road, Keynsham P2

HOUSE TYPE
AVEBURY (Detached)

DRAWING TITLE
GROUND FLOOR ELECTRICAL PLAN
-

SCALE	DATE	AUTHOR	CHK'D
1:50 @A3	Feb 24	LB	AF


DRAWING NO.
KEYN/AVE(D)/900

REV
C1

NOTE: *This drawing is the copyright of Curo Group, All rights reserved. DO NOT scale from this drawing. This drawing is only to be used on the site for which specified

Electrical Legend

S	Ceiling mounted smoke detector
HD	Ceiling mounted heat detector
F	Ceiling mounted extract fan
	Wall mounted extract fan
P	Pendant light fitting
	Downlighters
B	Batten light
	External light PIR
1 2 3	1 gang 1 way switch 1 gang 2 way switch 1 gang 3 way switch
R	Remote test / silent button for smoke detector in loft space
	13A switched double socket at low level
USB	13A switched double socket with USB at low level
MEDIA	Media plate (TV, FM, DAB, Data, SAT (2), BT, Double sockets (2)
	Shaver socket
	Telephone point
	Coaxial cable
	Door bell
	Door bell sounder
	Fused spur to extract fans and cylinder
BA	Unswitched fused spur for upgrade of wireless alarm
CL	Unswitched fused spur for upgrade of under cabinet lighting
	Blanking plate
	Outside tap
	BT Entry
	Thermostat
ONT	Fibre to the premises, with twin switched socket outlet installed next to FTTP socket. ONT box to be installed adjacent to the outside wall (as per Option 1 of Openreach Developer Guide).
CONSUMER	Consumer unit

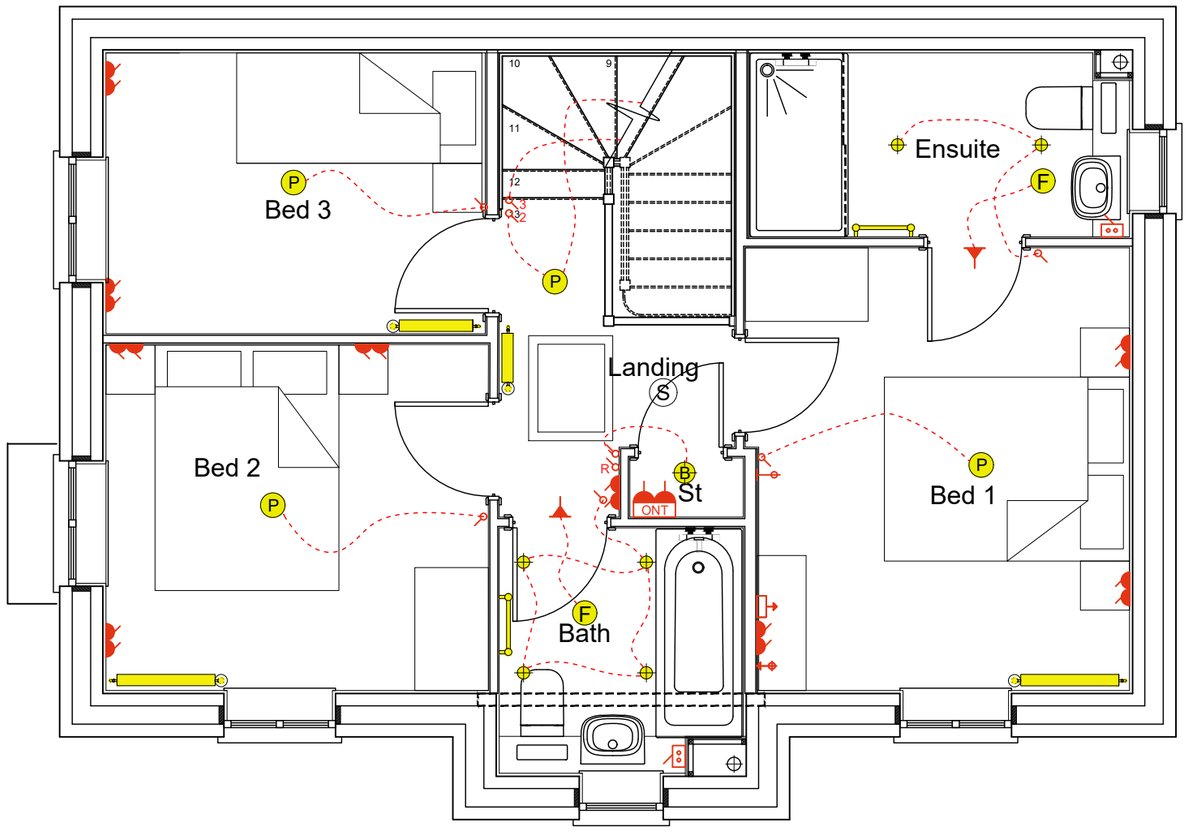

Notes

Electrical layout to be read in strict accordance with Curo internal specification

Switches & sockets, including door bells, entry phones, light switches, power sockets, TV aerials and telephone jacks, serving habitable rooms throughout the dwelling have their centre line 450-1200mm above floor level in accordance with AD M4(1) Diagram 1.5.

Consumer units to be mounted so that the switches are 1350-1450mm above FFL

Where M4(2) compliant requirements above to be met however sockets to installed minimum 300mm (measured horizontally) from an inside corner. AD M4(2) 2.30. Locate these sockets min 400mm from internal corner to centre line of socket

Any boiler timer controls & Thermostats to be mounted between 900mm and 1200mm above FFL. AD M4(2) 2.30

Number of socket outlets to meet NHBC standards as stated below and in accordance with NHBC 8.1.7 Table 6:

Kitchen = 8
Living / Family = 8 (minimum of 2 outlets near the TV aerial unit)
Bedrooms = 6 (4) (Minimum of 6 outlets for the main bedroom & minimum of 4 outlets for other bedrooms
Dining room = 4
Landing = 2
Hall = 2

Tenure: Open Market

AS
Plots 29, 37, 111

OPP
Plots 1, 10, 22, 48, 119, 132, 206

Rev.	Description.	Date.	Initial.
C1	Construction Issue	04.03.26	NW
-	Superstructure Tender Issue	07.02.25	NS

CONSTRUCTION

CURO GROUP

Standard House Type Collection

PROJECT
Bath Road, Keynsham P2

HOUSE TYPE
AVEBURY (Detached)


DRAWING TITLE
FIRST FLOOR ELECTRICAL PLAN
-

SCALE	DATE	AUTHOR	CHK'D
1:50 @A3	Feb 24	LB	AF

DRAWING NO.
KEYN/AVE(D)/901

REV
C1

NOTE: *This drawing is the copyright of Curo Group, All rights reserved. DO NOT scale from this drawing. This drawing is only to be used on the site for which specified

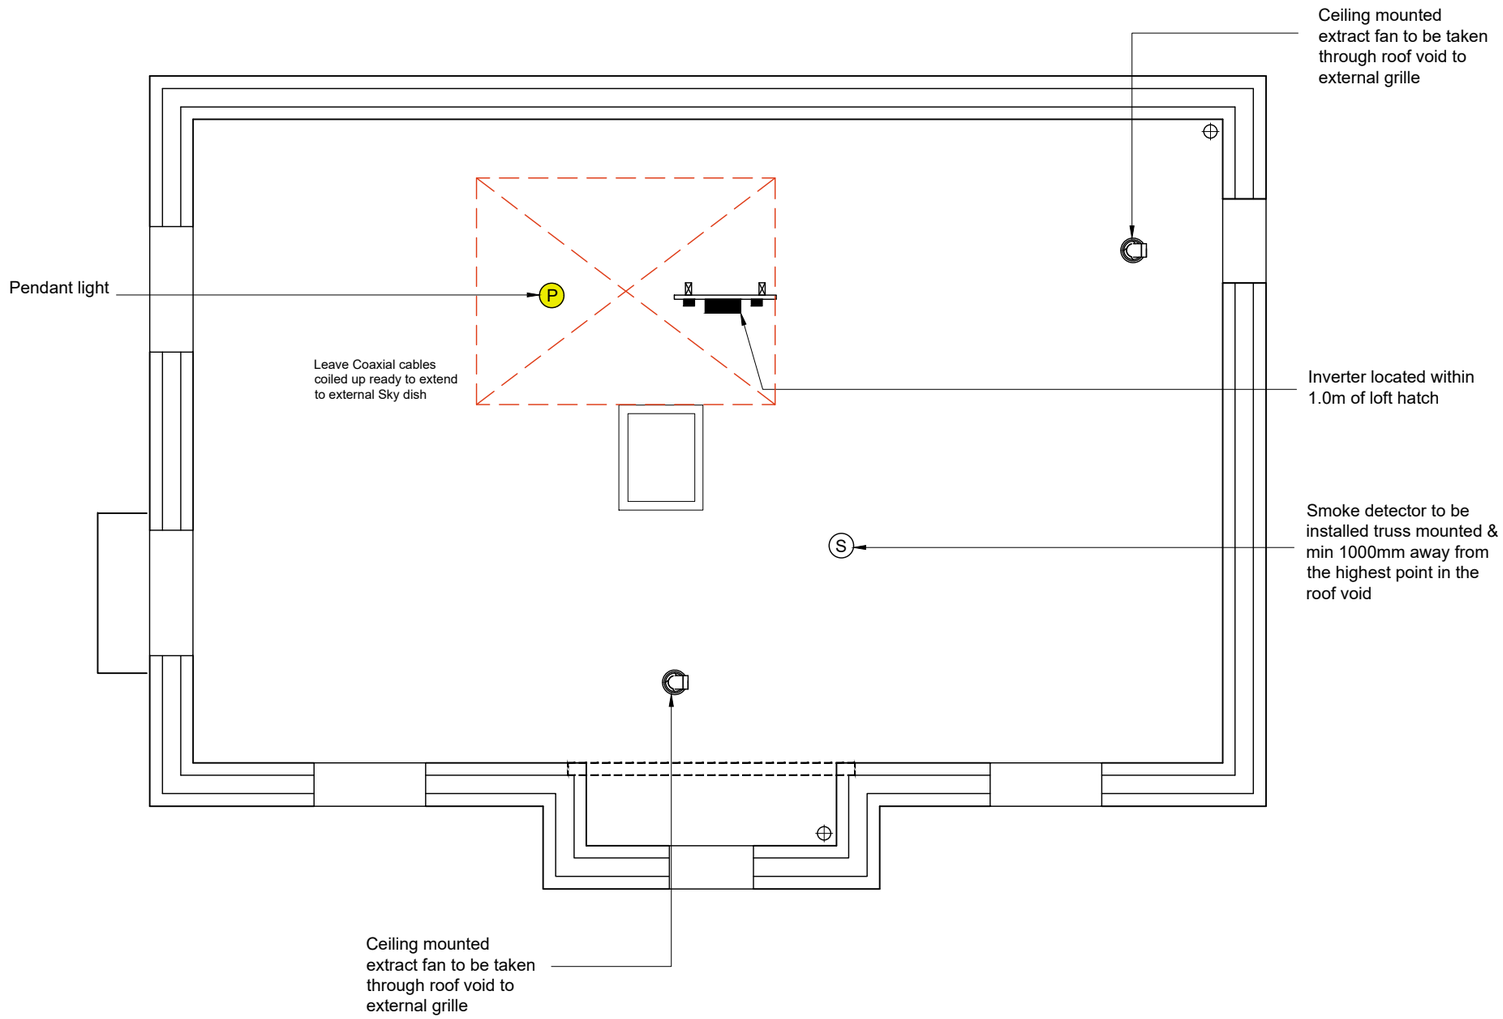

Solar PV Notes

AC Cable Requirements

- The site electrical contractor shall install a continuous 6mm twin cable & earth 6242Y from the consumer via a (local) loop and then to the loft space
- Approximately 2000mm of slack cable to be left clipped above the insulation at the inverter location
- The supply cable shall be selected and erected so as to comply with the latest requirements of BS 7671
- The PV system shall be installed on its own dedicated circuit where no other current using equipment is permitted
- Consumer unit - leave approximately 300mm inside the consumer unit. Do not terminate the cable, Eco2solar to do this during T&C of the system
- The local loop needs to project out 300mm so Eco2solar can install the AC isolator and the Gerneration meter
- The site electrical contractor shall also run a CAT5/6 shielded twisted pair (STP) from the DNO Utility meter (services head) to the inverter location

DC Cable Requirements

- DC cable in the loft space will be clipped to the timber work by Eco2solar installers unless other arrangements have been made prior
- All other locations will be by design, see drawing specification
- If the DC strings are run over a distance of 20m or buried in walls then there are two compliant methods available
  - 2 core steel wire armoured cables, sized as specification
  - or, metallic conduit to contain double insulated solar cables
- Note 6242Y T&E must not be used for DC strings or supplies

For detailed guidance refer to Eco2solar or similar approved site guide document

Tenure: Open Market

AS
Plots 29, 37, 111

OPP
Plots 1, 10, 22, 48, 119, 132, 206

Rev.	Description.	Date.	Initial.
C1	Construction Issue	04.03.26	NW
-	Superstructure Tender Issue	07.02.25	NS

CONSTRUCTION

CURO GROUP

Standard House Type Collection

PROJECT
Bath Road, Keynsham P2

HOUSE TYPE
AVEBURY (Detached)


DRAWING TITLE
ROOF M&E PLAN
-

SCALE	DATE	AUTHOR	CHK'D
1:50 @A3	Feb 24	LB	AF


DRAWING NO.
KEYN/AVE(D)/902

REV
C1

NOTE: *This drawing is the copyright of Curo Group, All rights reserved. DO NOT scale from this drawing. This drawing is only to be used on the site for which specified

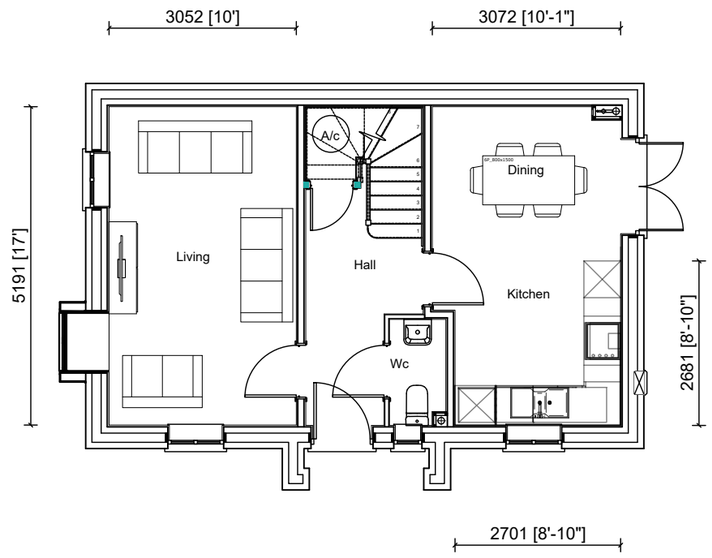

Ground Floor

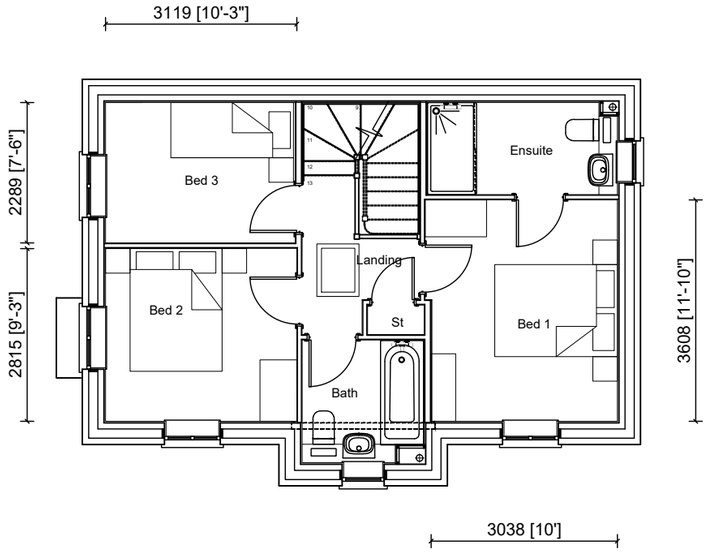

First Floor

Tenure: Open Market

AS
Plots 29, 37, 111

OPP
Plots 1, 10, 22, 48, 119, 132, 206

Rev.	Description.	Date.	Initial.
C1	Construction Issue	04.03.26	NW
-	Superstructure Tender Issue	07.02.25	NS

CONSTRUCTION

CURO GROUP

Standard House Type Collection

PROJECT
Bath Road, Keynsham P2

HOUSE TYPE
AVEBURY (Detached)

DRAWING TITLE
SALES PLANS
-

SCALE	DATE	AUTHOR	CHK'D
1:100 @A3	Feb 24	LB	AF

DRAWING NO.
KEYN/AVE(D)/1000

REV
C1

NOTE: *This drawing is the copyright of Curo Group, All rights reserved. DO NOT scale from this drawing. This drawing is only to be used on the site for which specified

DESIGN RISK ASSESSMENT

Design Location	Risk Element	Design risk	Option chosen	Reasoning	Residual Hazard - Special precautions by contractor or owner	Maintenance (post occupancy	Further Action
Internal	Lintels	Manual handling	Proprietary lintels / beams	Specialist advice	Contractor to complete a manual handling assessment prior to commencing work. Where possible mechanical aids should be used. Max weight - 52.47kg	None	None
Internal	Joists	Manual handling & fall potential	1. Sacrificial joists 2. Temporary handrails 3. Safety platform	To prevent falls through the stairwell void	Site to work to temporary works detail provided by the floor manufacturer to prevent fall. Sacrificial joist to include pedestrian hatch, and separate material slot. Temporary handrails to be in place around the stairwell prior to the sacrificial joist being removed. Site/contractors to use a safety platform e.g. Oxford system when the stud walls are constructed and temporary rails removed. All contractors working around and adjacent to stairwells to provide risk assessments and method statements	None	Consider checking regime of temporary handrails to ensure secure fixing. Site managers to monitor on their weekly HS&E sample.
External	Porches / low level roofs	Fall potential	Specialist designed roof trusses and concrete tile covering	Appearance & design	Construction to sequence work e.g build front elevation then construct the porch roof to avoid cantilever scaffold. If the above cannot be avoided - cantilever design required. Mastic works to be programmed whilst the scaffolding is in place. Maintenance of mastic - Customer to ensure suitable edge protection is in place		Information to be added to the H&S file
External	Doors & windows	Manual handling / Fall potential	Lightweight UPVC frame with glazed units	Appearance & design	Weights specified by manufacturer, see product literature for individual information. If blockwork is less than 950mm handrail required prior to windows being fitted. Manual handling assesment to be completed by contractor. Windows to be installed internally. Windows to be in accordance with BS8213-1:2014 safe cleaning requirements	Literature as per manufacturer. Easy clean hinges fitted where appropriate and suitably designed	Information on how to open/close/clean windows to be provided to customer
External	Roof overhang at wallplate	Fall potential	Specialist trusses with UPVC facia, soffits and guttering	Aesthetics	Division to highlight on the drawing to scaffolders. Scaffolders to plan width of scaffold to take into account the overhang on the 4th lift. When plotting sites they are to take into account the overhang of plots either side of the boundary to allow sufficient room for build/construction.	Maintenance caused by weathering	
Internal	Roof attic space	Fall potential	Specialist trusses with working platform for maintenance	Design	Division to ensure contractors who work in the roof space have an adequate platform, to spread the load over the trusses e.g. OSB boards under insulation, Oxford system, crawler boards. Contractors to detail arrangements in the Risk Assesment and Method statements	None	Information to be added to H&S file that the roof space is not to be loaded and is not a habitable area
Internal	Light fittings on first floor	Fall potential	Lighting fittings on landings	Appearance / design to provide adequate lighting near staircase for end user	Where light fittings are installed in and around the stairwell. The sub contractor should plan works to prevent falls e.g the Oxford landing system or safety platform system	Lights, bulbs, fittings will need to be replaced	Information to be added to H&S file
External	Openings	Fall potential	Temporary handrails	To prevent falls through openings, such as windows	Temporary handrails to be installed and positioned to any 1st or 2nd storey (window) opening with a cill level below 950mm. Any gap between the temporary handrail and other means of protection not to exceed 470mm. This protection is only to be removed directly prior to the installation of the window in the opening	None	Consider checking regime of temporary handrails to ensure secure fixing. Site managers to monitor on their weekly HS&E sample.

Rev.	Description.	Date.	Initial.
C1	Construction Issue	04.03.26	NW
-	Superstructure Tender Issue	07.02.25	NS

CONSTRUCTION

CURO GROUP

Standard House Type Collection

PROJECT
Bath Road, Keynsham P2

HOUSE TYPE
AVEBURY (Detached)

DRAWING TITLE
DESIGN RISK ASSESMENT
-

SCALE	DATE	AUTHOR	CHK'D
N/A @A3	Feb 24	LB	AF

DRAWING NO.
KEYN/AVE(D)/2000

REV
C1